


LOGAN CITY
(Falls 12)
LOT 197

PLAT OF A 0.107 ACRE LOT 197 FOR HERBERT AND SUE SPARKS

Situated in the City of Logan, Falls Township, Hocking County, Ohio; being Lot 197 of Dicken's Allotment as recorded in Plat Book B, Page 38, Hocking County Recorder's Office; being part of Section 12, Township 14, Range 17.

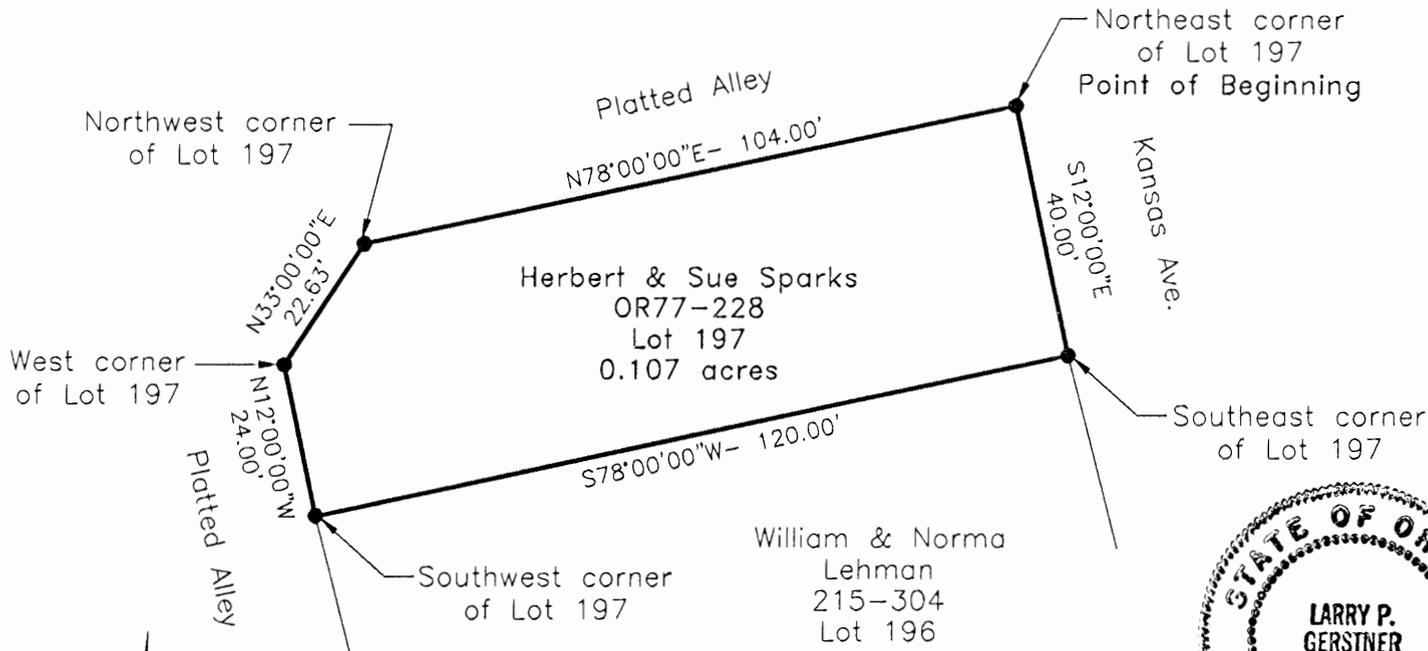


REFERENCES:

- Tax maps
- Deed descriptions
- Previous surveys
- Existing monumentation
- Existing subdivision plat

LEGEND:

- 5/8" x 30" iron pin with 1-1/4" plastic ID cap stamped LPG-6344 set

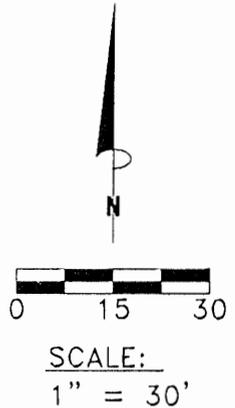

Approver: *Matthew Healy*
 Hocking County Engineer's Office
 By: *MAT* Date: 7-12-96

REFERENCE BEARING:

The Plat of Dicken's Allotment Lot 197. Bearings are base upon an assumed meridian and are to denote angles only.

CERTIFICATION:

I hereby certify that an actual survey was made under my supervision of the premises shown hereon on the 8th day of July, 1996 and that the plat is a correct representation of the premises as described by said survey.

Larry P. Gerstner
 Registered Surveyor No. 6344

Survey by: Larry P. Gerstner - Engineering and Surveying
 119 West Main Street, Logan, Ohio 43138 (614) 385-4260

SURVEY DESCRIPTION OF A .107 ACRE LOT 197 FOR HERBERT AND SUE SPARKS

Situated in the City of Logan, Falls Township, Hocking County, Ohio; being Lot 197 of Dicken's Allotment as recorded in Plat Book B, Page 38, Hocking County Recorder's Office; being part of Section 12, Township 14, Range 17; and being more particularly described as follows:

Beginning at a 5/8" iron pin set at the Northeast corner of said Lot 197; thence with the boundary of said Lot 197 the following five bearings and distances:

1) South 12 degrees 00 minutes 00 seconds East a distance of 40.00 feet to a 5/8" iron pin set at the Southeast corner of said Lot 197;

2) South 78 degrees 00 minutes 00 seconds West a distance of 120.00 feet to a 5/8" iron pin set at the Southwest corner of said Lot 197;


3) North 12 degrees 00 minutes 00 seconds West a distance of 24.00 feet to a 5/8" iron pin set at the West corner of said Lot 197;

4) North 33 degrees 00 minutes 00 seconds East a distance of 22.63 feet to a 5/8" iron pin set at the Northwest corner of said Lot 197;

5) North 78 degrees 00 minutes 00 seconds East a distance of 104.00 feet to the point of beginning, containing .107 acres more or less, and subject to any public or private easements of record.

The above .107 acre survey is intended to describe all of Lot 197 of Dicken's Allotment as deeded to Herbert and Sue Sparks, deed reference Volume OR 77, Page 228, Hocking County Recorder's Office. This survey was based upon information obtained from tax maps, deed descriptions, previous surveys, existing monumentation, and an existing subdivision plat. The reference bearing for this survey is the plat of Dicken's Allotment Lot 197. Bearings are based upon an assumed meridian and are to denote angles only. All iron pins set by this survey are 5/8" by 30" and are capped by a 1-1/4" plastic identification cap stamped LPG-6344. The above described property was surveyed by Larry P. Gerstner, Ohio Registered Surveyor No. 6344, on July 8, 1996.

Approved Mathematically
Hocking County Engineer's office
by JH Date 7-12-96

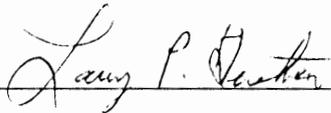



Survey by:
Larry P. Gerstner - Engineering and Surveying
119 West Main Street, Logan, Ohio 43138 385-4260



38

Logan City (12)
(FILE)

P.O. Box 26

GEORGE F. SEYMOUR & ASSOCIATES
Engineering, Surveying & Mapping Service
1013 West Hunter Street
Logan, Ohio 43138

Phone: 614/385-6150

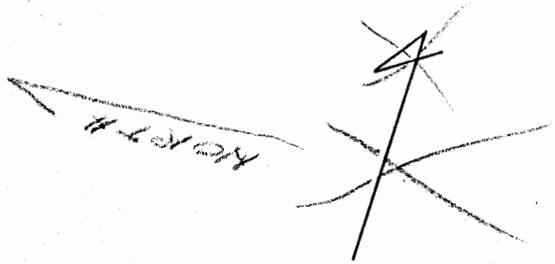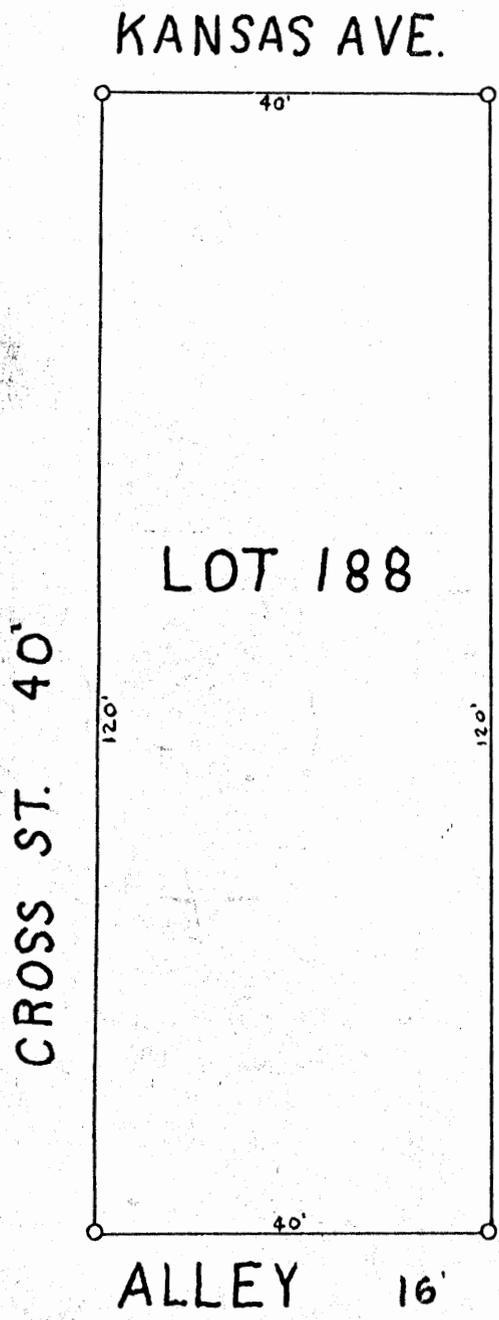


DICKEN'S ADD. PT.
SEC. # 12 FALLS TWP.

O = IRON PIN
SCALE = 1" = 20'

SURVEYED BY George F. Seymour
REGISTERED SURVEYOR # 6044

SURVEY PLAT OF .118 ACRE TRACT FOR ELOISE BARLOW

Situated in Falls Township, Hocking County, Ohio; being all of Lot 198 of Dicken's Allotment as recorded in Plat Book B, Page 38, Hocking County Recorder's Office; being now a part of the City of Logan and part of Section 12, Township 14, Range 17.

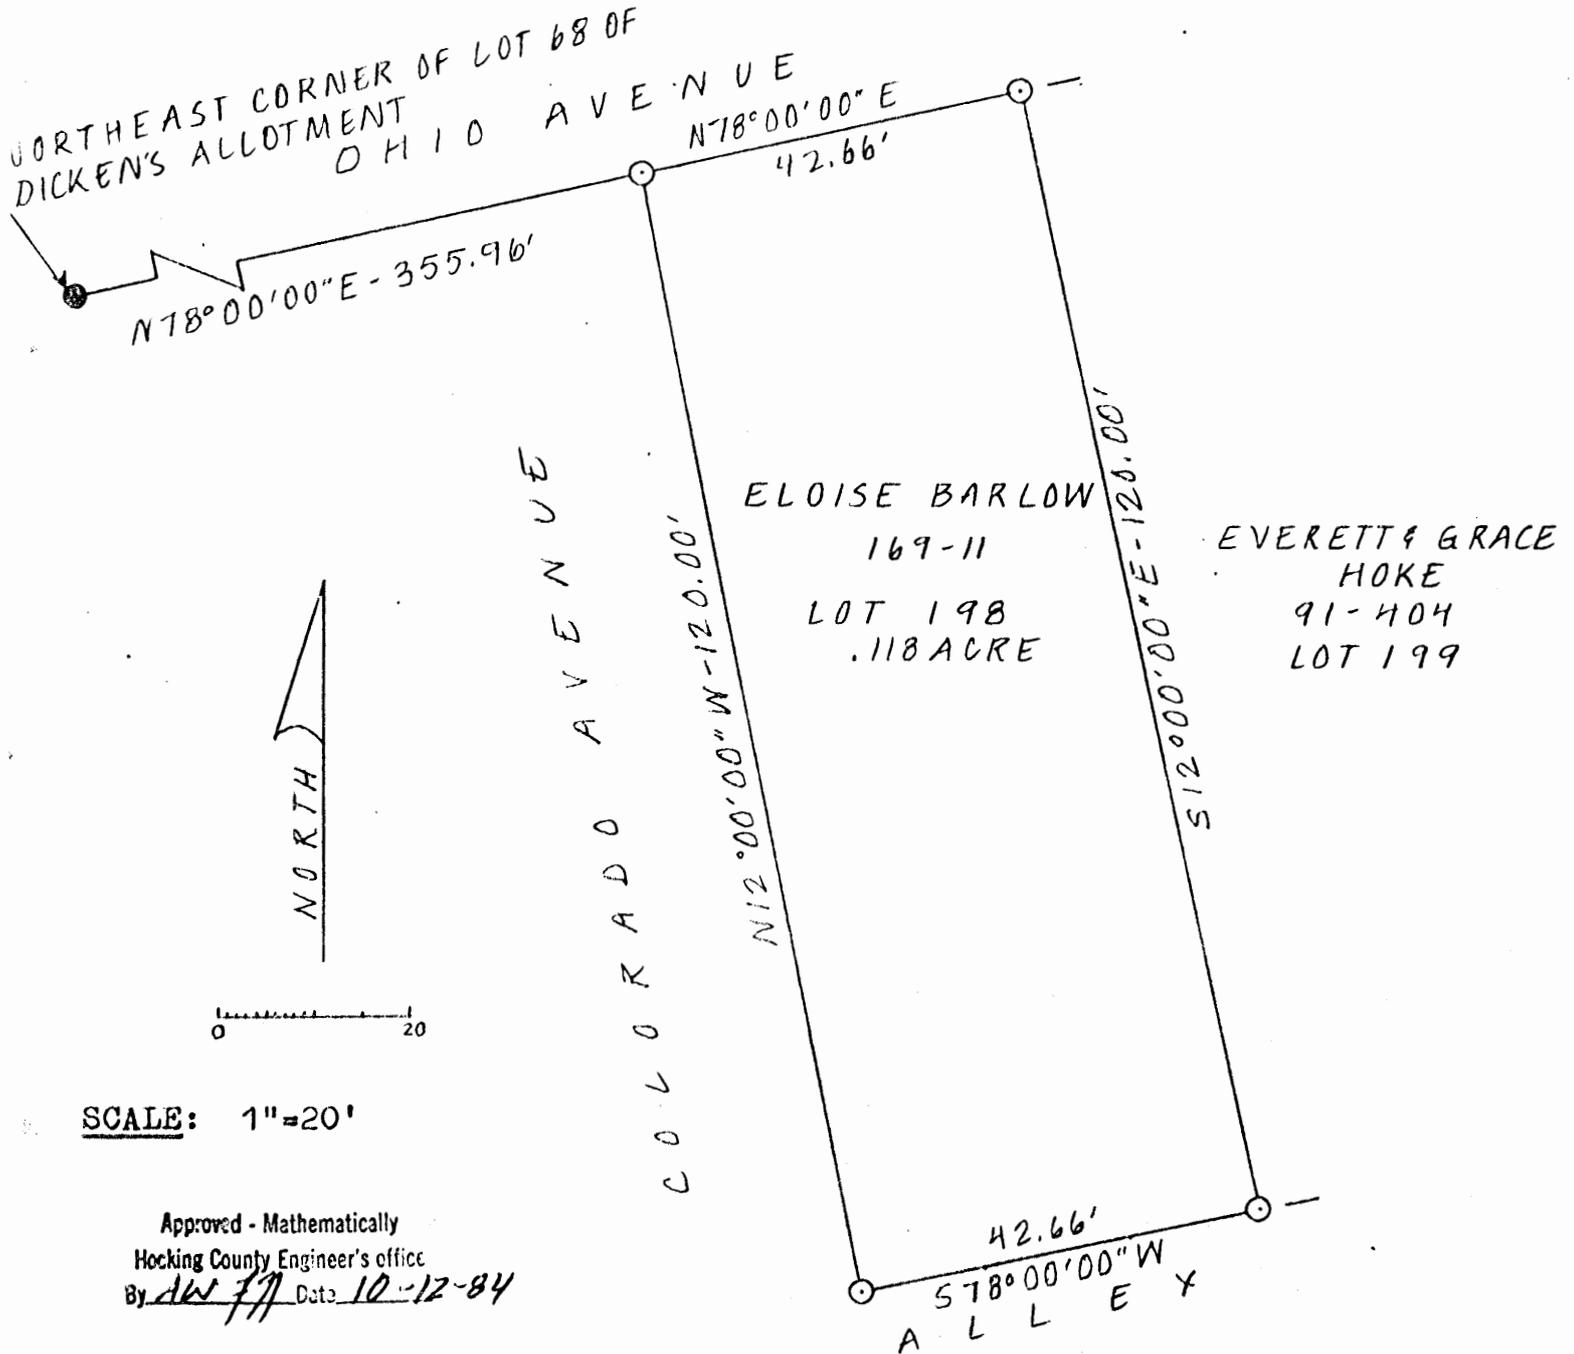

REFERENCE BEARING

North line of Lot 198 of said Dicken's Allotment as North 78°00'00" East.

REFERENCES

Tax maps
Deed descriptions
Previous surveys
Existing monumentation
Platted subdivision

LEGEND

- 5/8" Iron pin previously set
- 5/8" Iron pin with 1/4" plastic I.D. cap set

I hereby certify that an actual survey was made under my supervision of the premises shown hereon on the 10th day of October 1984 and that the plat is a correct representation of the premises as described by said survey.



Larry P. Gerstner
Registered Surveyor No. 6344

Survey by: EARTH WORKS - Surveying, Engineering & Construction
119 West Main Street, Logan, Ohio 43138 385-4260

SURVEY DESCRIPTION OF .118 ACRE TRACT FOR ELOISE BARLOW

Situated in Falls Township, Hocking County, Ohio; being all of Lot 198 of Dicken's Allotment as recorded in Plat Book B, Page 38, Hocking County Recorder's Office; being now a part of the City of Logan and part of Section 12, Township 14, Range 17; and being more particularly described as follows:

Commencing for reference at a 5/8" iron pin previously set at the Northeast corner of Lot 68 of said Dicken's Allotment; thence North 78 degrees 00 minutes 00 seconds East a distance of 355.96 feet to a 5/8" iron pin set at the Northwest corner of Lot 198 of said Dicken's Addition and being the point of Beginning of the tract of land to be described; thence with the North line of said Lot 198 North 78 degrees 00 minutes 00 seconds East a distance of 42.66 feet to a 5/8" iron pin set at the Northeast corner of said Lot 198; thence with the East line of said Lot 198 South 12 degrees 00 minutes 00 seconds East a distance of 120.00 feet to a 5/8" iron pin set at the Southeast corner of said Lot 198; thence with the South line of said Lot 198 South 78 degrees 00 minutes 00 seconds West a distance of 42.66 feet to a 5/8" iron pin set at the Southwest corner of said Lot 198; thence with the West line of said Lot 198 North 12 degrees 00 minutes 00 seconds West a distance of 120.00 feet to the point of beginning containing .118 acres more or less, subject to any private easements of record.

The above .118 acre survey is intended to describe all of Lot 198 of Dicken's Allotment as deeded to Eloise Barlow, deed reference Volume 163, Page 111, Hocking County Recorder's Office. This survey was based upon information obtained from tax maps, deed descriptions, previous surveys, existing monumentation, and a platted subdivision. The reference bearing for this survey is the North line of Lot 198 of said Dicken's Allotment as North 78 degrees 00 minutes 00 seconds East. All iron pins set by this survey are capped by a 1 1/4" plastic identification cap. The above described property was surveyed by Larry P. Gerstner, Ohio Registered Surveyor No. 6344, on October 10, 1984.




Larry P. Gerstner

Survey by:
EARTH WORKS - Surveying, Engineering, and Construction
119 West Main Street, Logan, Ohio 43138 385-4260

Approved - Mathematically
Hocking County Engineer's office
By *J. J. [Signature]* Date *10-12-84*

SURVEY PLAT OF .118 ACRE LOT 204 OF DICKEN'S ALLOTMENT Logan City
FOR HOCKING METROPOLITAN HOUSING AUTHORITY (Falls 12)

Situated on Ohio Avenue and Colorado Avenue in Falls Township, Hocking County, Ohio; being all of Lot 204 of Dicken's Allotment as recorded in Plat Book B, Page 38, Hocking County Recorder's Office; being now a part of the City of Logan and part of Section 12, Township 14, Range 17.

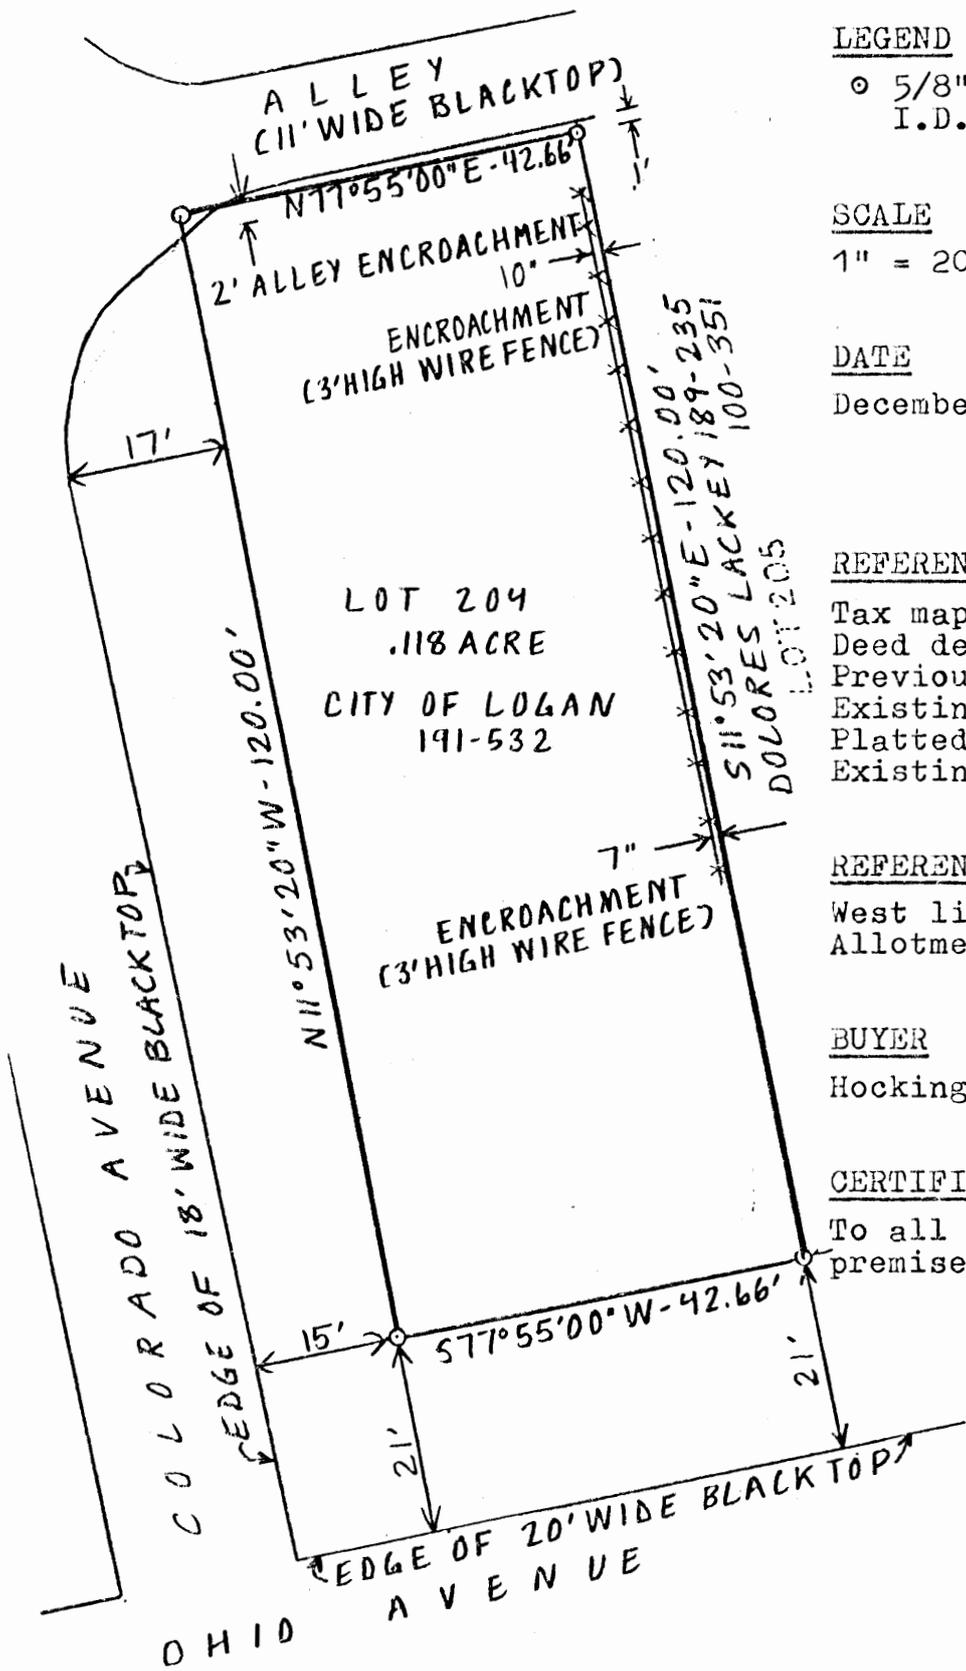

LEGEND

o 5/8" Iron pin with 1/4" plastic I.D. cap set

SCALE

1" = 20'

DATE

December 21, 1985

REFERENCES

- Tax maps
- Deed descriptions
- Previous surveys
- Existing monumentation
- Platted subdivision
- Existing public road

REFERENCE BEARING

West line of Lot 204 of Dicken's Allotment as North $11^{\circ}53'20''$ West.

BUYER

Hocking Metropolitan Housing Authority

CERTIFIED TO

To all parties interested in title to premises surveyed.



I hereby certify that I personally made an actual survey of the premises shown on this plot plan on the 21st day of December, 1985; that this plot plan is a correct representation of the premises as determined by said survey. I further certify that there are no encroachments either way across any boundary line of the premises except as shown hereon.

Signed at Logan, Ohio, this 26th day of December, 1985.

Larry P. Gerstner
 Registered Surveyor No. 6344



Approved - Mathematically
 Hocking County Engineer's office:
 By *PLNSM* Date *12-16-85*

Survey by: EARTH WORKS - Surveying, Engineering & Construction
 119 West Main Street, Logan, Ohio 43138 385-4260

SURVEY DESCRIPTION OF .118 ACRE LOT 204 OF DICKEN'S ALLOTMENT

FOR HOCKING METROPOLITAN HOUSING AUTHORITY

Situated in Falls Township, Hocking County, Ohio; being all of Lot 204 of Dicken's Allotment as recorded in Plat Book B, Page 38, Hocking County Recorder's Office; being now a part of the City of Logan and part of Section 12, Township 14, Range 17; and being more particularly described as follows:

Beginning at a 5/8" iron pin set at the Southwest corner of Lot 204; thence with the West line of Lot 204 North 11 degrees 53 minutes 20 seconds West a distance of 120.00 feet to a 5/8" iron pin set at the Northwest corner of Lot 204; thence with the North line of Lot 204 North 77 degrees 55 minutes 00 seconds East a distance of 42.66 feet to a 5/8" iron pin set at the Northeast corner of Lot 204; thence with the East line of Lot 204 South 11 degrees 53 minutes 20 seconds East a distance of 120.00 feet to a 5/8" iron pin set at the Southeast corner of Lot 204; thence with the South line of Lot 204 South 77 degrees 55 minutes 00 seconds West a distance of 42.66 feet to the point of beginning containing .118 acres more or less, subject to any private easements of record.

The above .118 acre survey is intended to describe all of Lot 204 of Dicken's Allotment as deeded to the City of Logan, deed reference Volume 191, Page 532, Hocking County Recorder's Office. This survey was based upon information obtained from tax maps, deed descriptions, previous surveys, existing monumentation, a platted subdivision, and an existing public road. The reference bearing for this survey is the West line of Lot 204 of Dicken's Allotment as North 11 degrees 53 minutes 20 seconds West. All iron pins set by this survey are capped by a 1-1/4" plastic identification cap. The above described property was surveyed by Larry P. Gerstner, Ohio Registered Surveyor No. 6344, on December 21, 1985.



Larry P. Gerstner


Survey by:

EARTH WORKS - Surveying, Engineering, and Construction
119 West Main Street, Logan, Ohio 43138 385-4260

Approved - Mathematically
Hocking County Engineer's office
By DFNSm Date 12-26-85

SURVEY PLAT OF .118 ACRE TRACT FOR JAMES DONALDSON

Situated in Falls Township, Hocking County, Ohio; being all of Lot 261 of Dicken's Allotment as recorded in Plat Book B, Page 38, Hocking County Recorder's Office; being now a part of the City of Logan and part of Section 12, Township 14, Range 17.

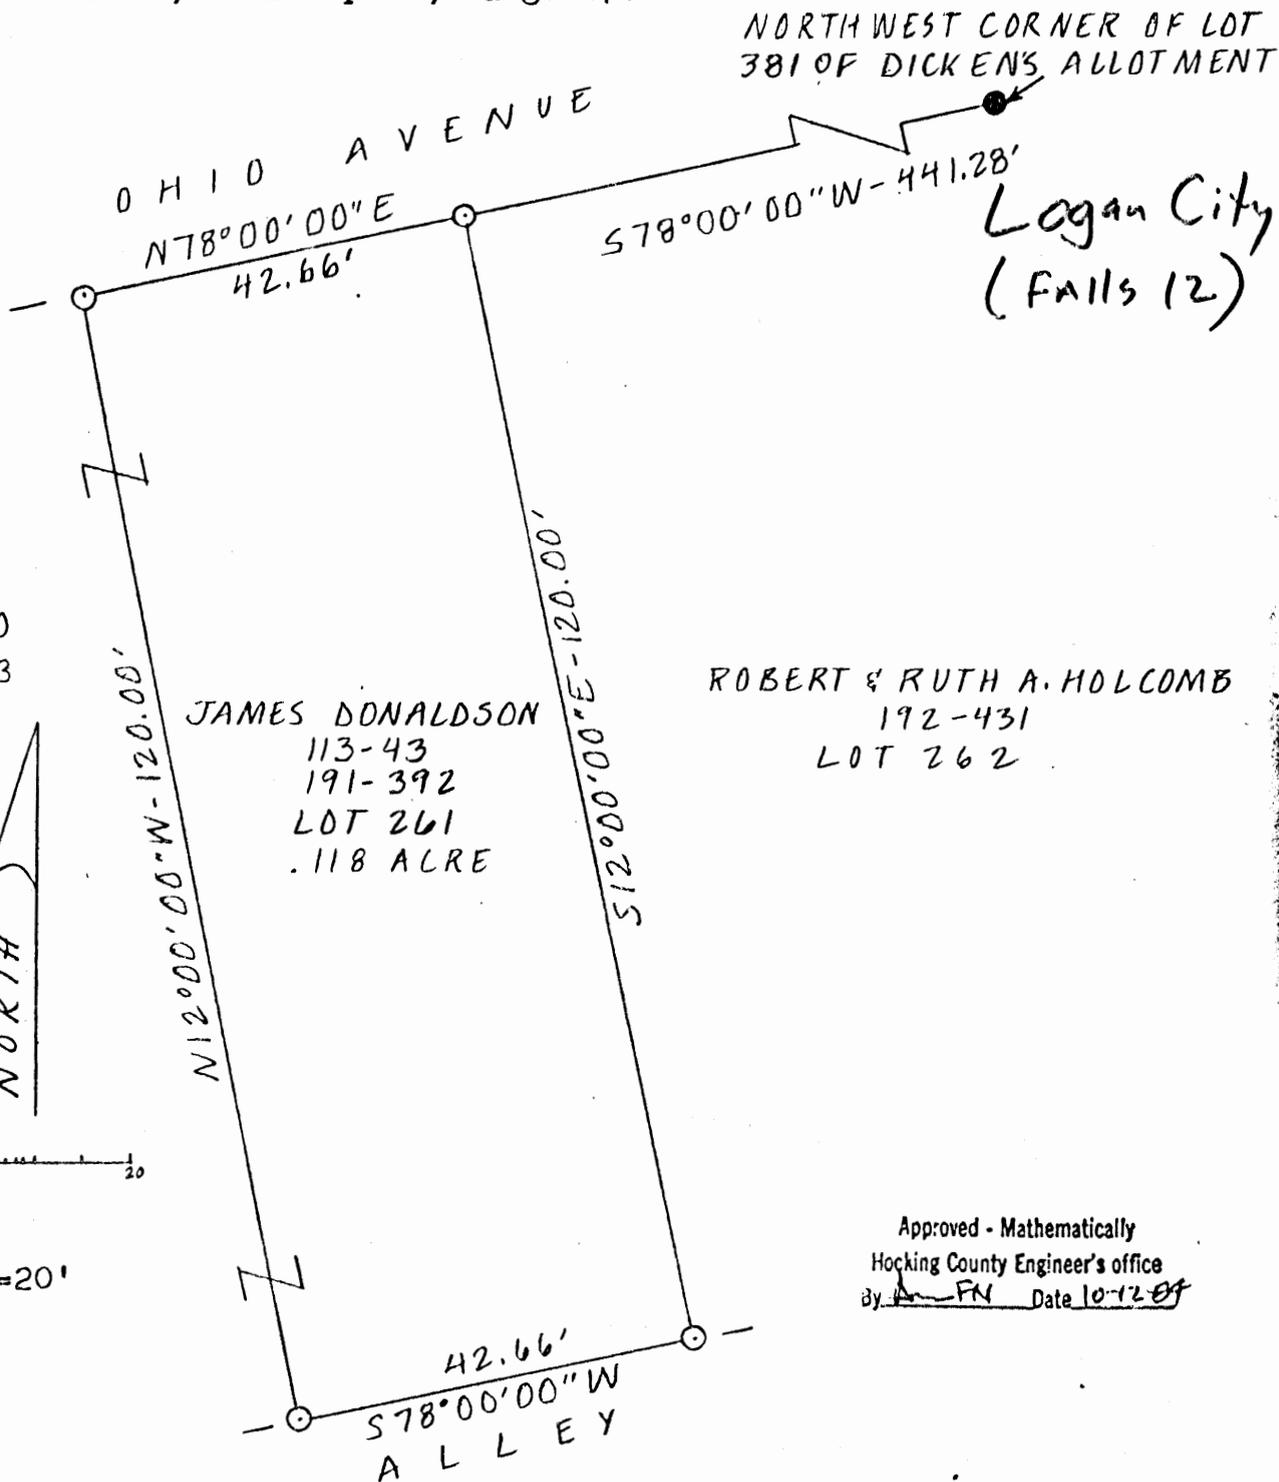

REFERENCE BEARING

North line of Lot 261 of said Dicken's Allotment as North 78°00'00" East.

REFERENCES

- Tax maps
- Deed descriptions
- Previous surveys
- Existing monumentation
- Platted subdivision

LEGEND

- 5/8" Iron pin found
- 5/8" Iron pin with 1/4" plastic I.D. cap set

I hereby certify that an actual survey was made under my supervision of the premises shown hereon on the 10th day of October 1984 and that the plat is a correct representation of the premises as described by said survey.



Larry P. Gerstner
Registered Surveyor No. 6344

Survey by: EARTH WORKS - Surveying, Engineering & Construction
119 West Main Street, Logan, Ohio 43138 385-4260

SURVEY DESCRIPTION OF .118 ACRE TRACT FOR JAMES DONALDSON

Situated in Falls Township, Hocking County, Ohio; being all of Lot 261 of Dicken's Allotment as recorded in Plat Book B, Page 38, Hocking County Recorder's Office; being now a part of the City of Logan and part of Section 12, Township 14, Range 17; and being more particularly described as follows:

Commencing for reference at a 5/8" iron pin found at the Northwest corner of Lot 381 of said Dicken's Allotment; thence South 78 degrees 00 minutes 00 seconds West a distance of 441.28 feet to a 5/8" iron pin set at the Northeast corner of Lot 261 of said Dicken's Allotment and being the point of Beginning of the tract of land to be described; thence with the East line of said Lot 261 South 12 degrees 00 minutes 00 seconds East a distance of 120.00 feet to a 5/8" iron pin set at the Southeast corner of said Lot 261; thence with the South line of said Lot 261 South 78 degrees 00 minutes 00 seconds West a distance of 42.66 feet to a 5/8" iron pin set at the Southwest corner of said Lot 261; thence with the West line of said Lot 261 North 12 degrees 00 minutes 00 seconds West a distance of 120.00 feet to the Northwest corner of said Lot 261; thence with the North line of said Lot 261 North 78 degrees 00 minutes 00 seconds East a distance of 42.66 feet to the point of beginning containing .118 acres more or less, subject to any private easements of record.

The above .118 acre survey is intended to describe all of Lot 261 of Dicken's Allotment as deeded to James Donaldson, dead reference Volumes 113 and 191, Pages 43 and 392, Hocking County Recorder's Office. This survey was based upon information obtained from tax maps, deed descriptions, previous surveys, existing monumentation, and a platted subdivision. The reference bearing for this survey is the North line of Lot 261 of said Dicken's Allotment as North 78 degrees 00 minutes 00 seconds East. All iron pins set by this survey are capped by a 1 1/4" plastic identification cap. The above described property was surveyed by Larry P. Gerstner, Ohio Registered Surveyor No. 6344, on October 10, 1984.



Larry P. Gerstner


Survey by:

EARTH WORKS - Surveying, Engineering, and Construction
119 West Main Street, Logan, Ohio 43138 385-4260

Approved - Mathematically
Hocking County Engineer's office
By A-FN Date 10-12-84

SURVEY PLAT OF .235 ACRE TRACT FOR ROBERT AND RUTH HOLCOMB

Situated in Falls Township, Hocking County, Ohio; being all of Lots 262 and 263 of Dicken's Allotment as recorded in Plat Book B, Page 38, Hocking County Recorder's Office; being now a part of the City of Logan and part of Section 12, Township 14, Range 17.

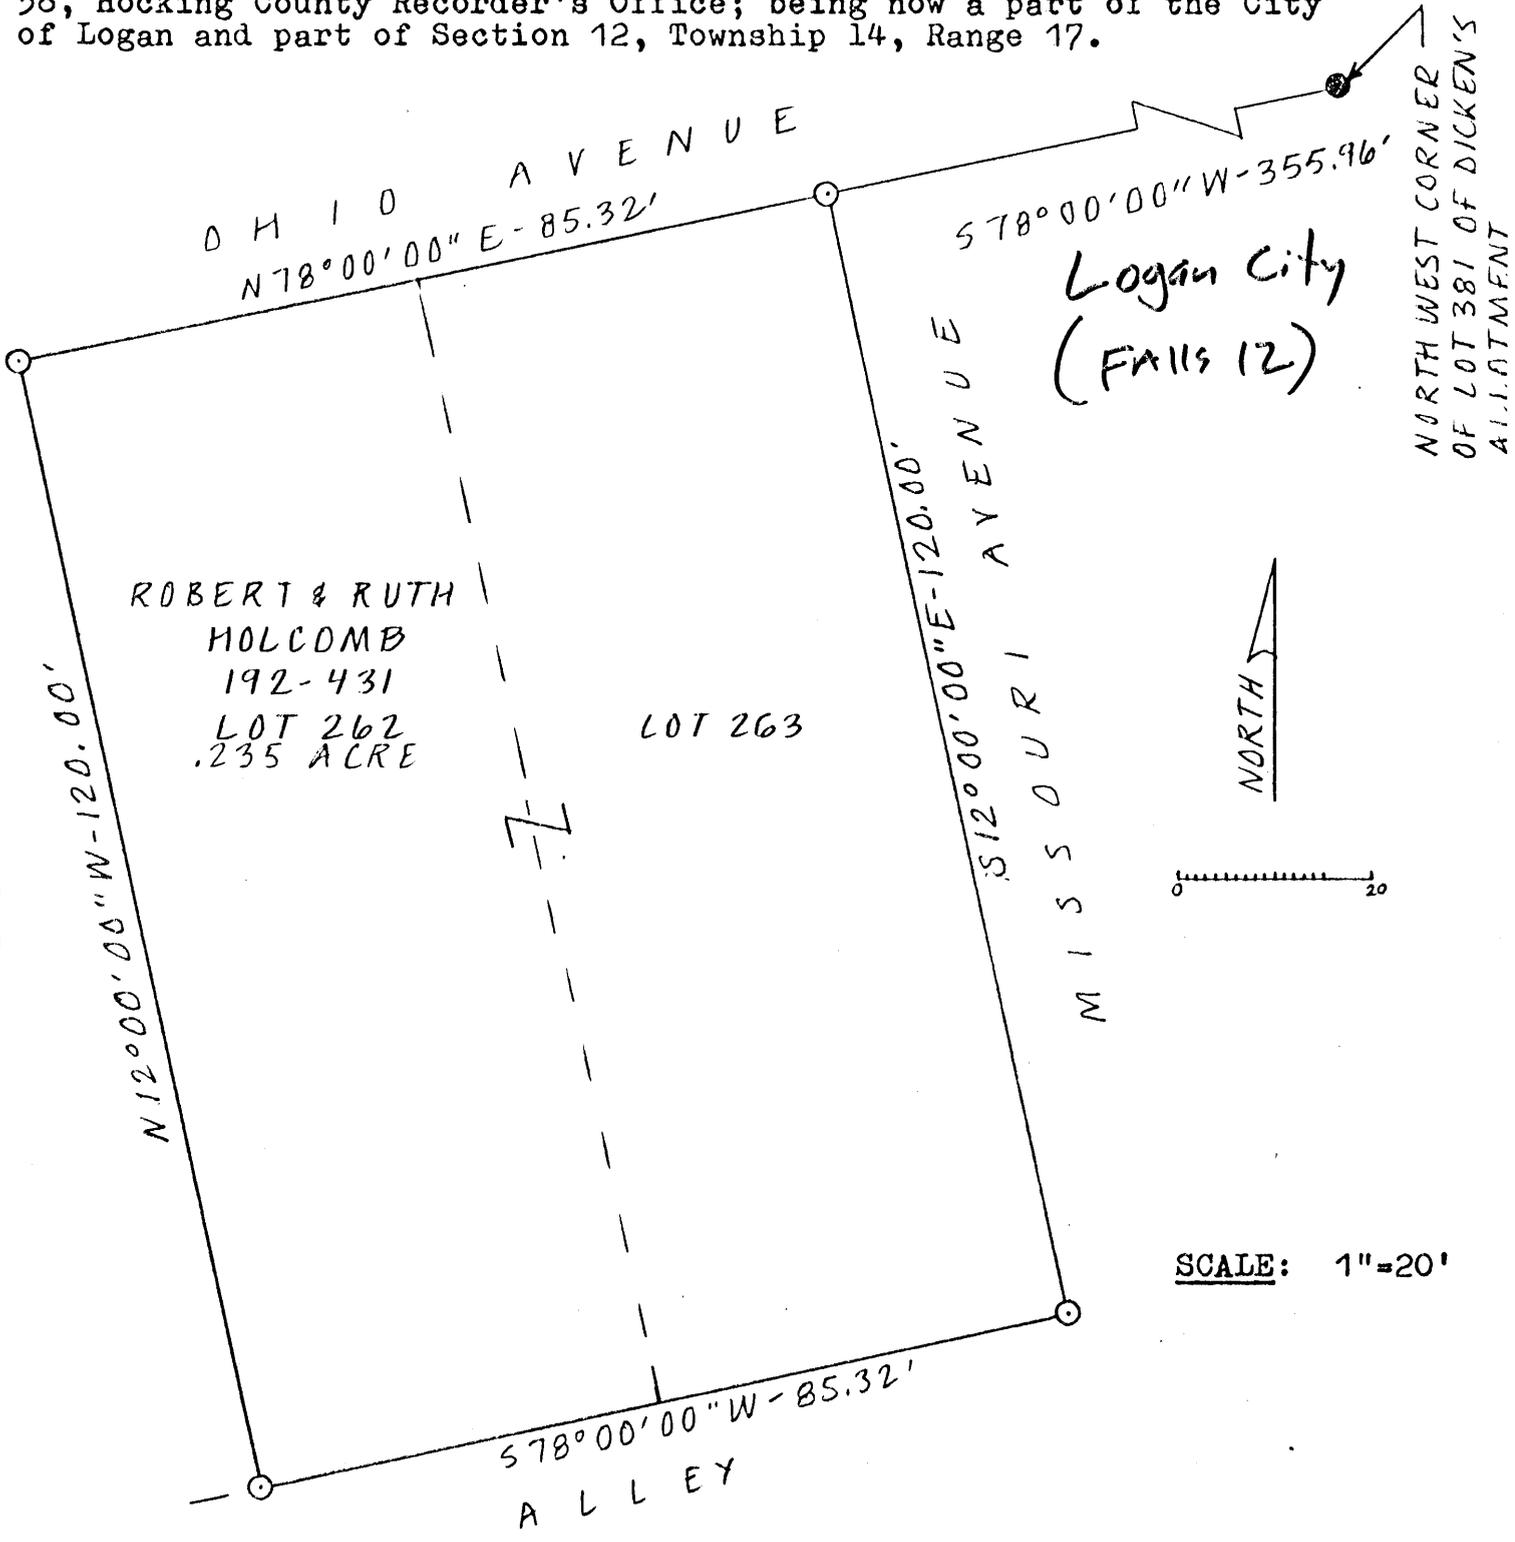

JAMES DONALDSON
113-43, 191-392

REFERENCE BEARING

North line of Lots 262 and 263 of said Dicken's Allotment as North 78° 00' 00" East.

REFERENCES

- Tax maps
- Deed descriptions
- Previous surveys
- Existing monumentation
- Platted subdivision

LEGEND

- 5/8" Iron pin found
- 5/8" Iron pin with 1/4" plastic I.D. cap set

I hereby certify that an actual survey was made under my supervision of the premises shown hereon on the 10th day of October 1984 and that the plat is a correct representation of the premises as described by said survey.

Larry P. Gerstner
Registered Surveyor No. 6344

Approved - Mathematically
Hocking County Engineer's office
By *ArFN* Date *10-12-84*



Survey by: EARTH WORKS - Surveying, Engineering & Construction
119 West Main Street, Logan, Ohio 43138 385-4260

SURVEY DESCRIPTION OF .235 ACRE TRACT FOR ROBERT AND RUTH HOLCOMB

Situated in Falls Township, Hocking County, Ohio; being all of Lots 262 and 263 of Dicken's Allotment as recorded in Plat Book B, Page 38, Hocking County Recorder's Office; being now a part of the City of Logan and part of Section 12, Township 14, Range 17; and being more particularly described as follows:

Commencing for reference at a 5/8" iron pin found at the Northwest corner of Lot 381 of said Dicken's Allotment; thence South 78 degrees 00 minutes 00 seconds West a distance of 355.96 feet to a 5/8" iron pin set at the Northeast corner of Lot 263 of said Dicken's Allotment and being the point of Beginning of the tract of land to be described; thence with the East line of said Lot 263 South 12 degrees 00 minutes 00 seconds East a distance of 120.00 feet to a 5/8" iron pin set at the Southeast corner of said Lot 263; thence with the South line of said Lots 263 and 262 South 78 degrees 00 minutes 00 seconds West a distance of 85.32 feet to a 5/8" iron pin set at the Southwest corner of said Lot 262; thence with the West line of said Lot 262 North 12 degrees 00 minutes 00 seconds West a distance of 120.00 feet to the Northwest corner of said Lot 262; thence with the North line of said Lots 262 and 263 North 78 degrees 00 minutes 00 seconds East a distance of 85.32 feet to the point of beginning containing .235 acres more or less, subject to any private easements of record.

The above .235 acre survey is intended to describe all of Lots 262 and 263 of Dicken's Allotment as deeded to Robert and Ruth Holcomb, deed reference Volume 192, Page 431, Hocking County Recorder's Office. This survey was based upon information obtained from tax maps, deed descriptions, previous surveys, existing monumentation, and a platted subdivision. The reference bearing for this survey is the North line of Lots 262 and 263 of said Dicken's Allotment as North 78 degrees 00 minutes 00 seconds East. All iron pins set by this survey are capped by a 1 1/4" plastic identification cap. The above described property was surveyed by Larry P. Gerstner, Ohio Registered Surveyor No. 6344, on October 10, 1984.



Larry P. Gerstner



Survey by:
EARTH WORKS - Surveying, Engineering, and Construction
119 West Main Street, Logan, Ohio 43138 385-4260

Approved - Mathematically
Hocking County Engineer's office
By LN Date 10-12-87

Logan City
(Falls 12 Lot 294 Pt. Dicken Alley)

BEING A PART OF LOT NO. 29A OF DICKENS ALLOT-
MENT TO THE CITY OF LOGAN AS RECORDED IN
PLAT BK. "B", PG. 38, HOCKING CO. PLAT RECORDS


NOTE: CITED BEARINGS ARE BASED ON THE NORTH LINE OF LOT
NO. 29A AS BEARING N 78° 00' 00" E.

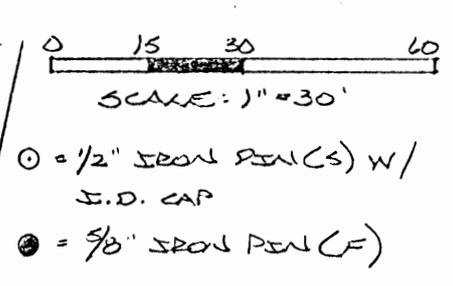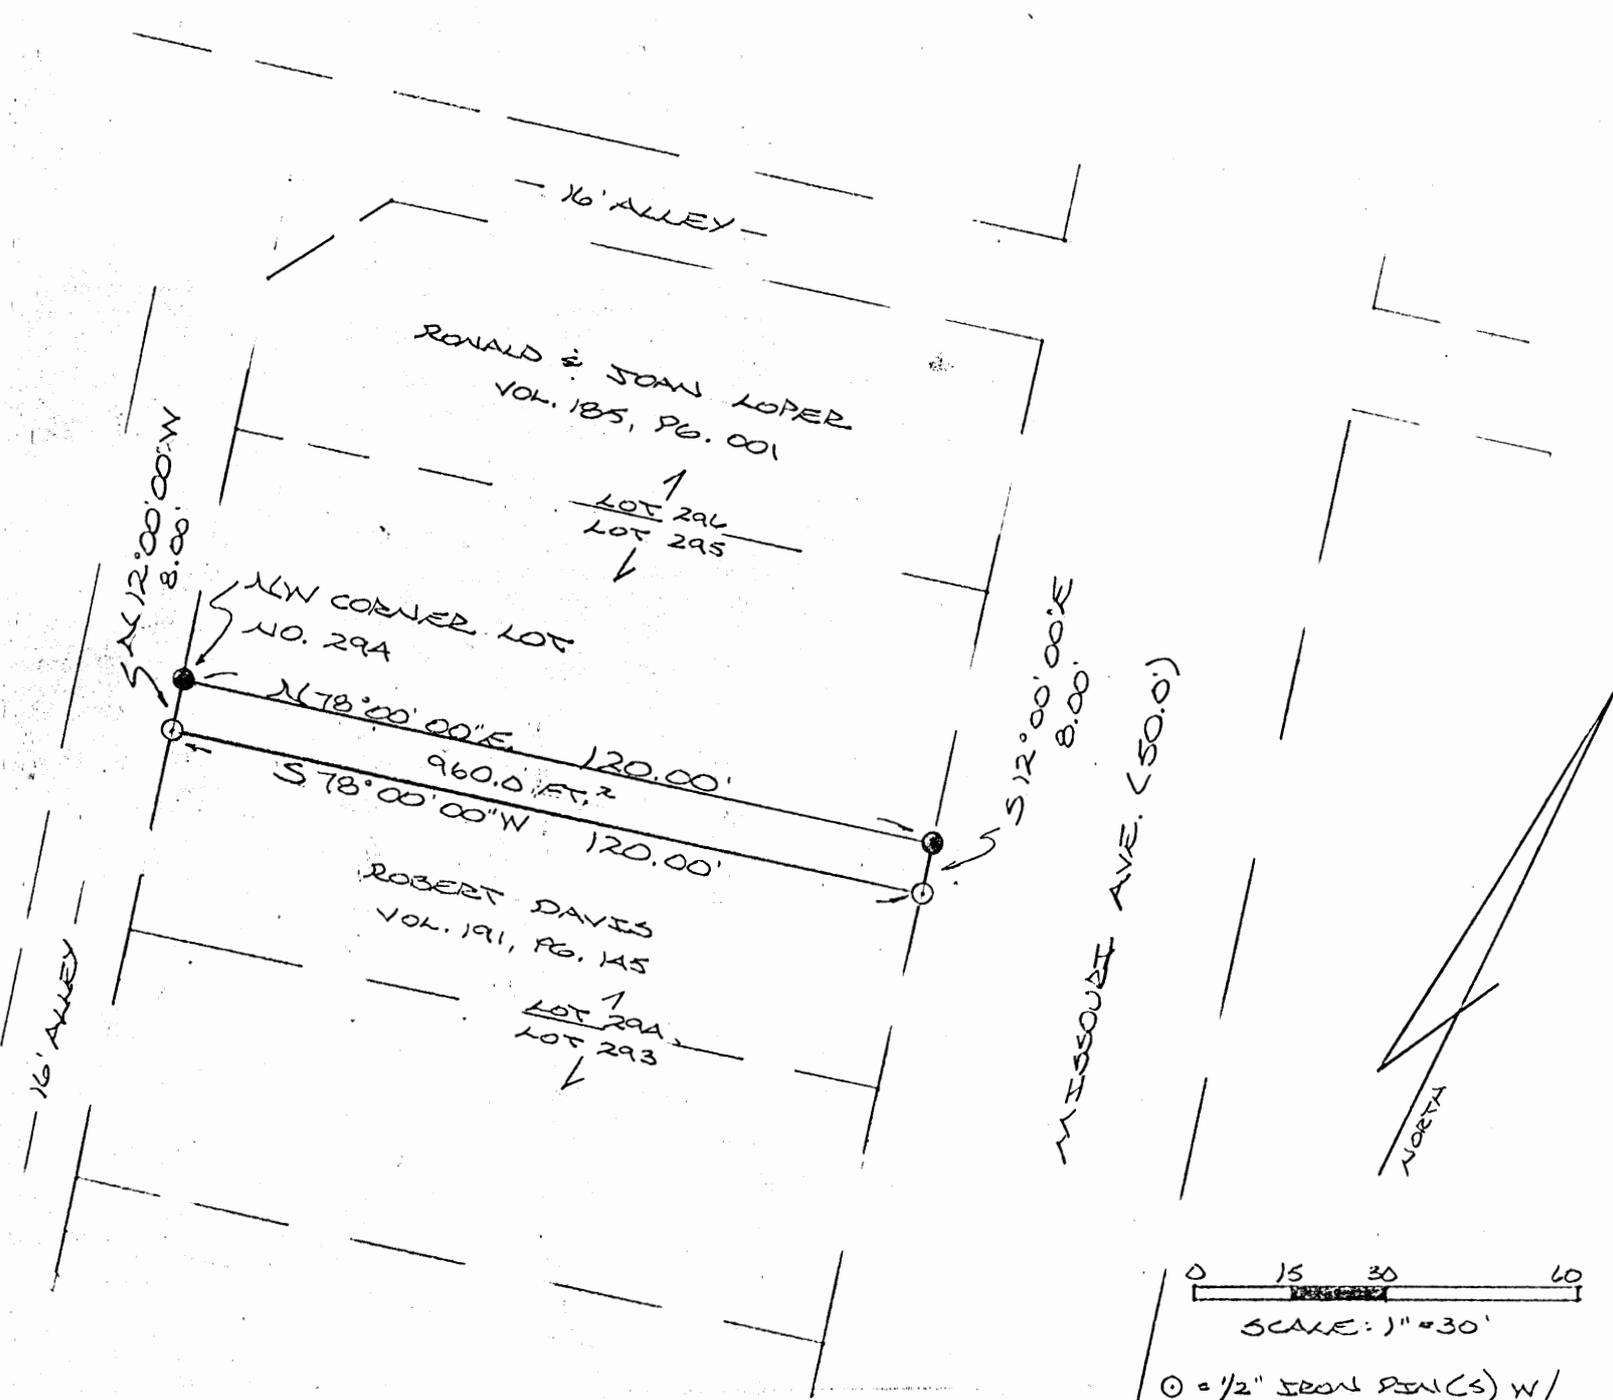

Approved - Mathematically
 Hocking County Engineer's office
 By M.A.W. Date 7-22-87
~~* Pending City Planning Comm.~~
 Approval - Prior to Transfer

REFERENCES:
 COUNTY TAX PLATS
 SURVEYS OF RECORD
 PLAT BK. "B", PG. 38
 DEEDS (AS NOTED)

SURVEYED & PLATTED BY:
M. J. O. P. Berry (7-21-87)
 OHIO REGISTERED SURVEYOR NO. 6200

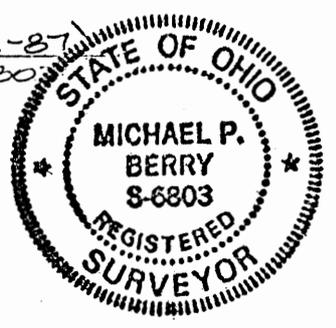

DESCRIPTION OF SURVEY FOR MR. & MRS. RONALD LOPER

Being a part of a tract of land last transferred to Robert Davis in Vol. 191, Pg. 145, Hocking Co. Deed Records, situated in Lot No. 294 of Dicken's Allotment as delineated in Plat Bk. "B", Pg. 38, Hocking Co. Plat Records, being now a part of the city of Logan, Sec. 12, Falls Twp., T-14N, R-17W, Hocking Co., Ohio, and being more particularly described as follows:

Beginning at a 5/8" iron pin found on the NW corner of Lot No. 294;

Thence, with the north line of said lot, N 78° 00' 00" E a distance of 120.00 ft. to a 5/8" iron pin found;

Thence, with the east line of said Lot No. 294, S 12° 00' 00" E a distance of 8.00 ft. to an iron pin set;

Thence, with a new line, S 78° 00' 00" W a distance of 120.00 ft. to an iron pin set on the west line of said Lot No. 294;


Thence, with said west line, N 12° 00' 00" W a distance of 8.00 ft. to the place of beginning, containing 960.0 ft.² and being subject to all valid easements.

Cited bearings are based on the north line of Lot No. 294 as running N 78° 00' 00" E.

All iron pins described as being set are 1/2" X 30" with an attached plastic identification cap.

The above description is the result of an actual survey made by Michael P. Berry, Ohio Registered Surveyor No. 6803, on July 21, 1987.


Approved - Mathematically
Hocking County Engineer's office
By MPB Date 7-22-87
~~Pending City Planning Comm.~~
~~Approval Prior To Transfer~~

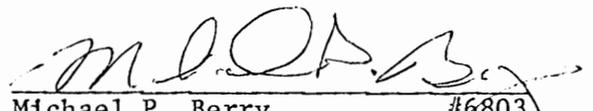
Michael P. Berry #6803

PLAT OF .217 ACRE LOTS 297 AND 298 OF DICKEN ADDITION FOR PAUL CLONCH

LOGAN CITY
Lot 297, 298
DICKEN ALLOT


Situated in Falls Township, Hocking County, Ohio; being all of Lots 297 and 298 of Dicken's Allotment as recorded in Plat Book B, Page 38, Hocking County Recorder's Office; being now a part of the City of Logan and part of Section 12, Township 14, Range 17.

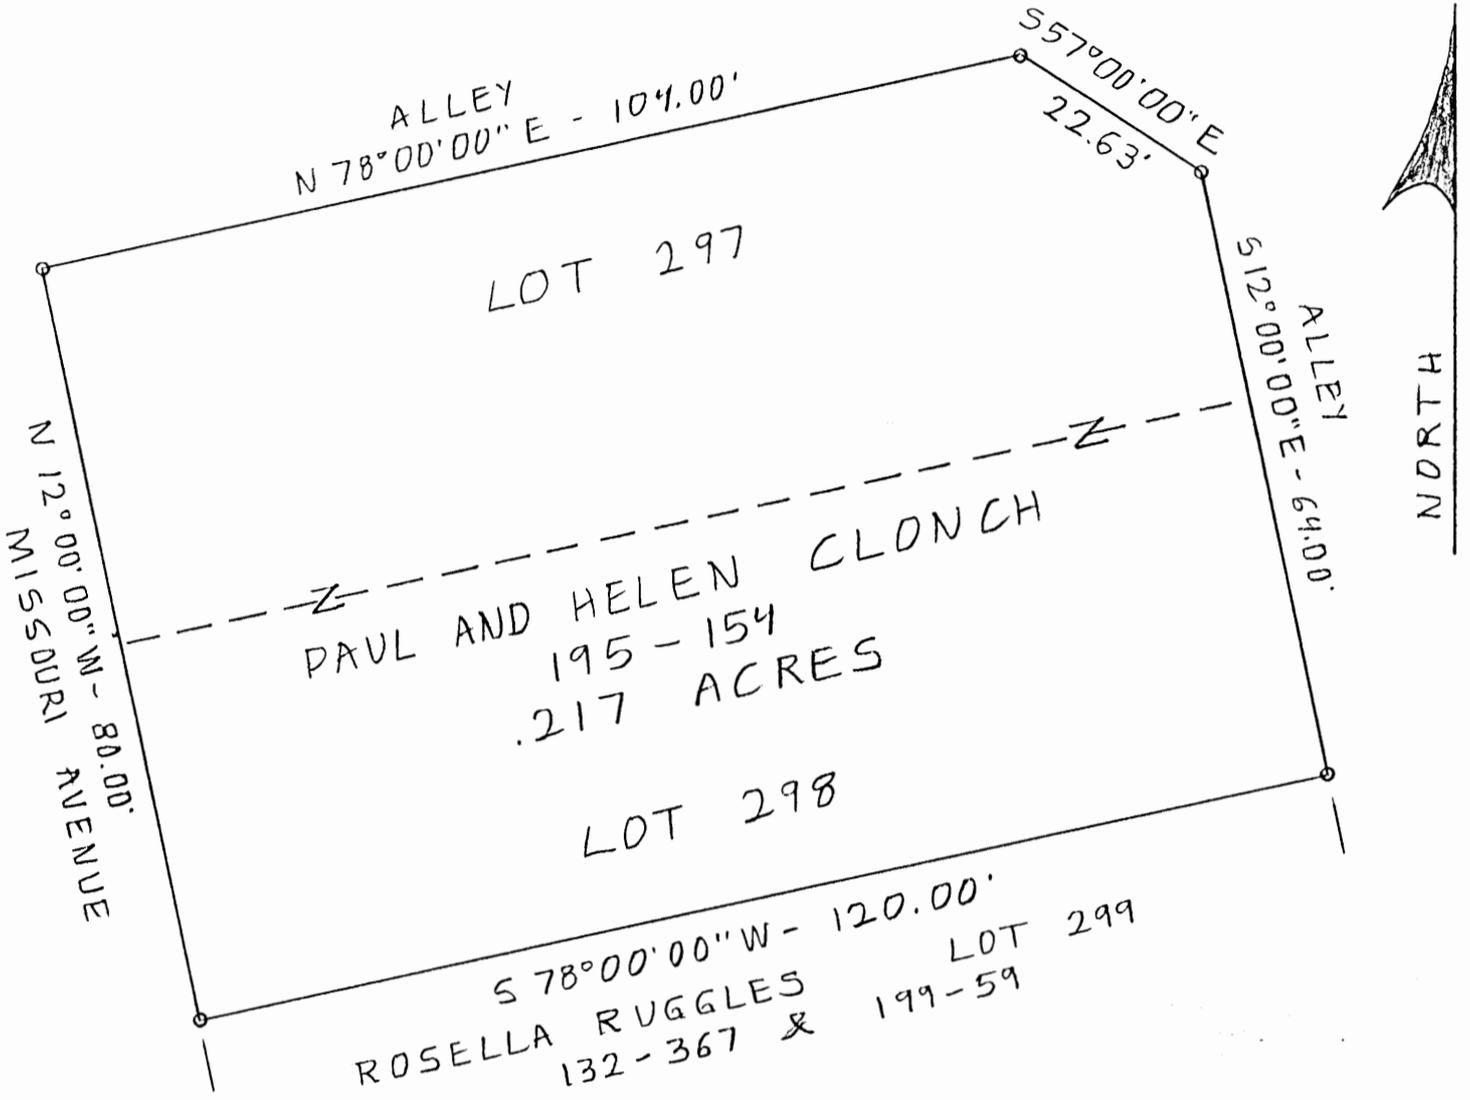

LEGEND:

- o 5/8" iron pin with 1 1/4" plastic ID cap set

SCALE:

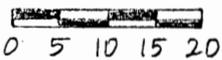1" = 20' 

REFERENCE BEARING:

Plat of Dicken's Allotment.


REFERENCES:

- Tax maps
- Deed descriptions
- Previous surveys
- Existing monumentation
- Platted subdivision

Approved - Mathematically
Hocking County Engineer's office
By  Date 8-24-90



I hereby certify that an actual survey was made under my supervision of the premises shown hereon on the 23rd day of August, 1990 and that the plat is a correct representation of the premises as described by said survey.

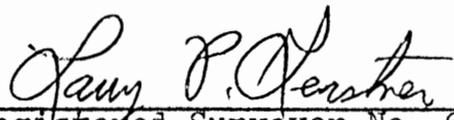
Registered Surveyor No. 6344

Survey by: Larry P. Gerstner - Engineering and Surveying
119 West Main St., Logan, Ohio 43138 385-4260

SURVEY DESCRIPTION OF .217 ACRE LOTS 297 AND 298
OF DICKEN ADDITION FOR PAUL CLONCH

Situated in Falls Township, Hocking County, Ohio; being all of Lots 297 and 298 of Dicken's Allotment as recorded in Plat Book B, Page 38, Hocking County Recorder's Office; being now a part of the City of Logan and part of Section 12, Township 14, Range 17; and being more particularly described as follows:

Beginning at a 5/8" iron pin set at the Southwest corner of Lot 298; thence with the West line of Lots 298 and 297 North 12 degrees 00 minutes 00 seconds West a distance of 80.00 feet to a 5/8" iron pin set at the Northwest corner of Lot 297;

thence with the North line of Lot 297 North 78 degrees 00 minutes 00 seconds East a distance of 104.00 feet to a 5/8" iron pin set;

thence with the Northeast line of Lot 297 South 57 degrees 00 minutes 00 seconds East a distance of 22.63 feet to a 5/8" iron pin set;

thence with the East line of Lots 297 and 298 South 12 degrees 00 minutes 00 seconds East a distance of 64.00 feet to a 5/8" iron pin set at the Southeast corner of Lot 298;

thence with the South line of Lot 298 South 78 degrees 00 minutes 00 seconds West a distance of 120.00 feet to the point of Beginning, containing .217 acres more or less, subject to any public and private easements of record.

The above .217 acre survey is intended to describe all of Lots 297 and 298 of Dicken's Allotment as deeded to Paul and Helen Clonch, deed reference Volume 195, Page 154, Hocking County Recorder's Office. This survey was based upon information obtained from tax maps, deed descriptions, previous surveys, existing monumentation, and a platted subdivision. The reference bearing for this survey is the plat of Dicken's Allotment. All iron pins set by this survey are capped by a 1-1/4" plastic identification cap. The above described property was surveyed by Larry P. Gerstner, Ohio Registered Surveyor No. 6344, on August 23, 1990.



Larry P. Gerstner

Approved - Mathematically
Hocking County Engineer's office
By *[Signature]* Date 8-24-10

Survey by:
Larry P. Gerstner - Engineering and Surveying
119 West Main Street, Logan, Ohio 43138 385-4260


38

SURVEY PLAT OF .220 ACRE LOTS 238 AND 239

Logan City (Fall 12)

OF DICKEN'S ALLOTMENT FOR HOCKING METROPOLITAN HOUSING AUTHORITY

Situated on Kansas Avenue, in Falls Township, Hocking County, Ohio; being all Lots 238 and 239 of Dicken's Allotment as recorded in Plat Book B, Page 38, Hocking County Recorder's Office; being now a part of the City of Logan and part of Section 12, Township 14, Range 17.

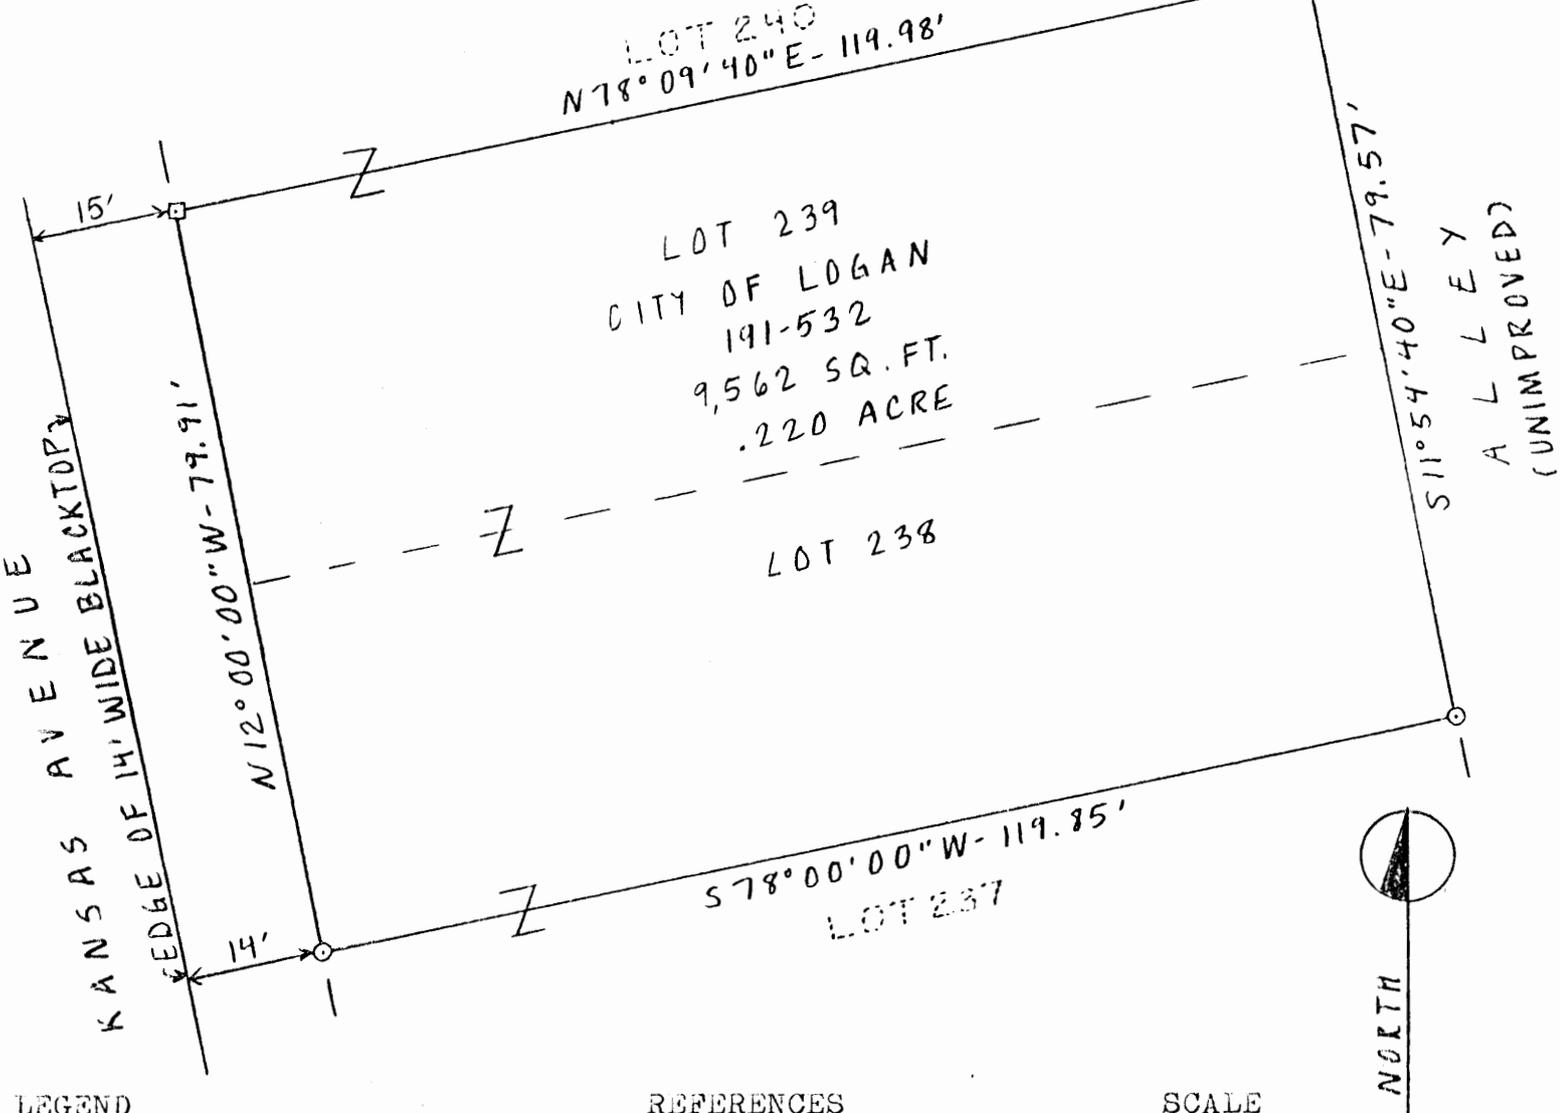

LEGEND

- 1 1/2" Iron bolt found
- 5/8" Iron pin with 1/4" plastic I.D. cap set

REFERENCES

- Tax maps
- Deed descriptions
- Previous surveys
- Existing monumentation
- Platted subdivision
- Existing public road

SCALE

1" = 20'

DATE

December 21, 1985

REFERENCE BEARING

West line of Lots 238 and 239 of Dicken's Allotment as North 12°00'00" West.

BUYER

Hocking Metropolitan Housing Authority

CERTIFIED TO

To all parties interested in title to premises surveyed.

I hereby certify that I personally made an actual survey of the premises shown on this plot plan on the 21st day of December, 1985; that this plot plan is a correct representation of the premises as determined by said survey. I further certify that there are no encroachments either way across any boundary line of the premises except as shown hereon.

Signed at Logan, Ohio, this 26th day of December, 1985.

Larry P. Gerstner

Registered Surveyor No. 6344



Approved - Mathematically
Hocking County Engineer's office
By *D. ENSM* Date *12-26-85*

Survey by: EARTH WORKS - Surveying, Engineering & Construction
119 West Main Street, Logan, Ohio 43138 385-4260

SURVEY DESCRIPTION OF .220 ACRE LOTS 238 AND 239

OF DICKEN'S ALLOTMENT FOR HOCKING METROPOLITAN HOUSING AUTHORITY

Situated in Falls Township, Hocking County, Ohio; being all of Lots 238 and 239 of Dicken's Allotment as recorded in Plat Book B, Page 38, Hocking County Recorder's Office; being now a part of the City of Logan and part of Section 12, Township 14, Range 17; and being more particularly described as follows:

Beginning at a 1-1/2" iron bolt found at the Northwest corner of Lot 239; thence with the North line of Lot 239 North 78 degrees 09 minutes 40 seconds East a distance of 119.98 feet to a 1-1/2" iron bolt found at the Northeast corner of Lot 239; thence with the East line of Lots 239 and 238 South 11 degrees 54 minutes 40 seconds East a distance of 79.57 feet to a 5/8" iron pin set at the Southeast corner of Lot 238; thence with the South line of Lot 238 South 78 degrees 00 minutes 00 seconds West a distance of 119.85 feet to a 5/8" iron pin set at the Southwest corner of Lot 238; thence with the West line of Lots 238 and 239 North 12 degrees 00 minutes 00 seconds West a distance of 79.91 feet to the point of beginning containing .220 acres more or less, subject to any private easements of record.

The above .220 acre survey is intended to describe all of Lots 238 and 239 of Dicken's Allotment as deeded to the City of Logan, deed reference Volume 191, Page 532, Hocking County Recorder's Office. This survey was based upon information obtained from tax maps, deed descriptions, previous surveys, existing monumentation, a platted subdivision, and an existing public road. The reference bearing for this survey is the West line of Lots 238 and 239 of Dicken's Allotment as North 12 degrees 00 minutes 00 seconds West. All iron pins set by this survey are capped by a 1-1/4" plastic identification cap. The above described property was surveyed by Larry P. Gerstner, Ohio Registered Surveyor No. 6344, on December 21, 1985.



Larry P. Gerstner

Survey by:

EARTH WORKS - Surveying, Engineering, and Construction
119 West Main Street, Logan, Ohio 43138 385-4260

Approved - Mathematically
Hocking County Engineer's office
By DEN Date 12-26-85


38

SURVEY PLAT OF .219 ACRE LOTS 236 AND 237

Logan City
(Falls 12)

OF DICKEN'S ALLOTMENT FOR HOCKING METROPOLITAN HOUSING AUTHORITY

Situated on Kansas Avenue, in Falls Township, Hocking County, Ohio; being all Lots 236 and 237 of Dicken's Allotment as recorded in Plat Book B, Page 38, Hocking County Recorder's Office; being now a part of the City of Logan and part of Section 12, Township 14, Range 17.

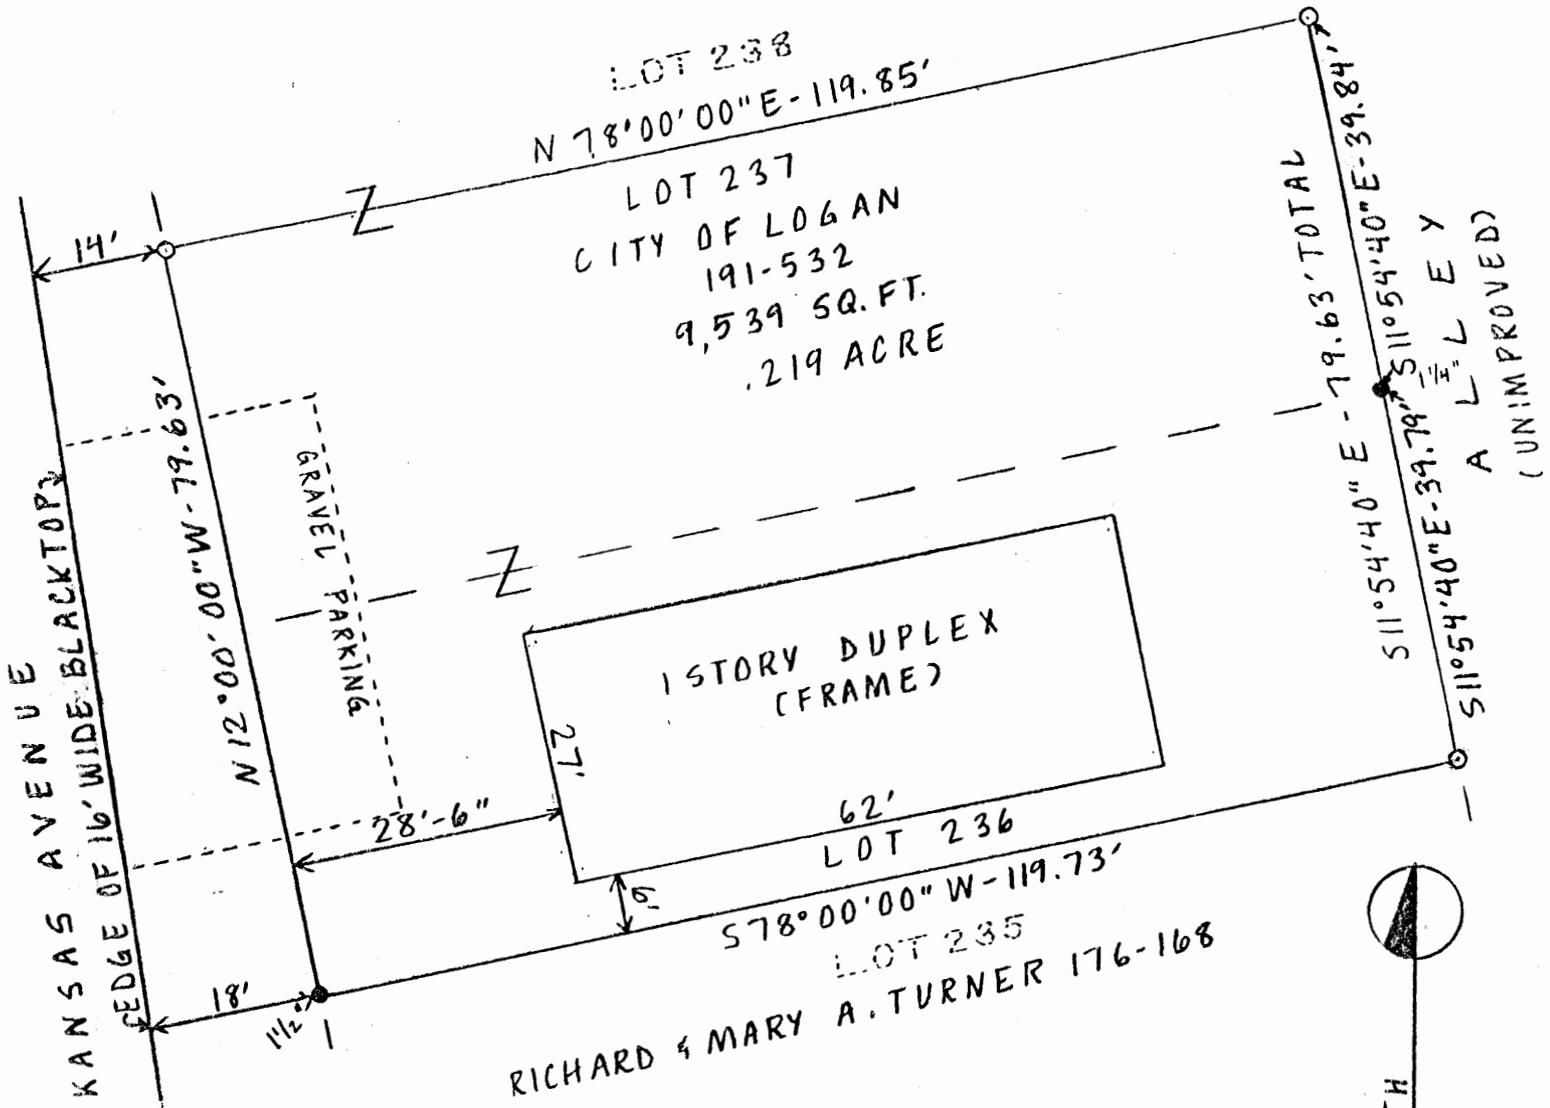

LEGEND

- Iron pipe found
- 5/8" Iron pin with 1/4" plastic I.D. cap set

REFERENCES

- Tax maps
- Deed descriptions
- Previous surveys
- Existing monumentation
- Platted subdivision
- Existing public road

SCALE

1" = 20'

DATE

December 21, 1985

REFERENCE BEARING

West line of Lots 236 and 237 of Dicken's Allotment as North 12°00'00" West.

BUYER

Hocking Metropolitan Housing Authority

CERTIFIED TO

To all parties interested in title to premises surveyed.

I hereby certify that I personally made an actual survey of the premises shown on this plot plan on the 21st day of December, 1985; that this plot plan is a correct representation of the premises as determined by said survey. I further certify that there are no encroachments either way across any boundary line of the premises except as shown hereon.

Signed at Logan, Ohio, this 26th day of December, 1985.



Approved - Mathematically
Hocking County Engineer's office
By DFNSM Date 12-20-85

Larry P. Gerstner
Registered Surveyor No. 6344

Survey by: EARTH WORKS - Surveying, Engineering & Construction
119 West Main Street, Logan, Ohio 43138 385-4260

SURVEY DESCRIPTION OF .219 ACRE LOTS 236 AND 237

OF DICKEN'S ALLOTMENT FOR HOCKING METROPOLITAN HOUSING AUTHORITY

Situated in Falls Township, Hocking County, Ohio; being all of Lots 236 and 237 of Dicken's Allotment as recorded in Plat Book B, Page 38, Hocking County Recorder's Office; being now a part of the City of Logan and part of Section 12, Township 14, Range 17; and being more particularly described as follows:

Beginning at a 1-1/2" iron pipe found at the Southwest corner of Lot 236; thence with the West line of Lots 236 and 237 North 12 degrees 00 minutes 00 seconds West a distance of 79.63 feet to a 5/8" iron pin set at the Northwest corner of Lot 237; thence with the North line of Lot 237 North 78 degrees 00 minutes 00 seconds East a distance of 119.85 feet to a 5/8" iron pin set at the Northeast corner of Lot 237; thence with the East line of Lot 237 South 11 degrees 54 minutes 40 seconds East a distance of 39.84 feet to a 1-1/4" iron pipe found at the Southeast corner of Lot 237; thence continuing South 11 degrees 54 minutes 40 seconds East a distance of 39.79 feet to a 5/8" iron pin set at the Southeast corner of Lot 236; thence with the South line of Lot 236 South 78 degrees 00 minutes 00 seconds West a distance of 119.73 feet to the point of beginning containing .219 acres more or less, subject to any private easements of record.

The above .219 acre survey is intended to describe all of Lots 236 and 237 of Dicken's Allotment as deeded to the City of Logan, deed reference Volume 191, Page 532, Hocking County Recorder's Office. This survey was based upon information obtained from tax maps, deed descriptions, previous surveys, existing monumentation, a platted subdivision, and an existing public road. The reference bearing for this survey is the West line of Lots 236 and 237 of Dicken's Allotment as North 12 degrees 00 minutes 00 seconds West. All iron pins set by this survey are capped by a 1-1/4" plastic identification cap. The above described property was surveyed by Larry P. Gerstner, Ohio Registered Surveyor No. 6344, on December 21, 1985.



Larry P. Gerstner

Survey by:


EARTH WORKS - Surveying, Engineering, and Construction
119 West Main Street, Logan, Ohio 43138 385-4260

Approved - Mathematically
Hocking County Engineer's office
By DuFENSM Date 12-26-85

SURVEY PLAT OF .220 ACRE LOTS 229 and 230 OF DICKEN'S ALLOTMENT *Logan City*
 FOR HOCKING METROPOLITAN HOUSING AUTHORITY *(Falls 12)*

38

Situated on Kansas Avenue in Falls Township, Hocking County, Ohio; being all of lots 229 and 230 of Dicken's Allotment as recorded in Plat Book B, Page 38, Hocking County Recorder's office; being now a part of the City of Logan and part of Section 12, Township 14, Range 17.

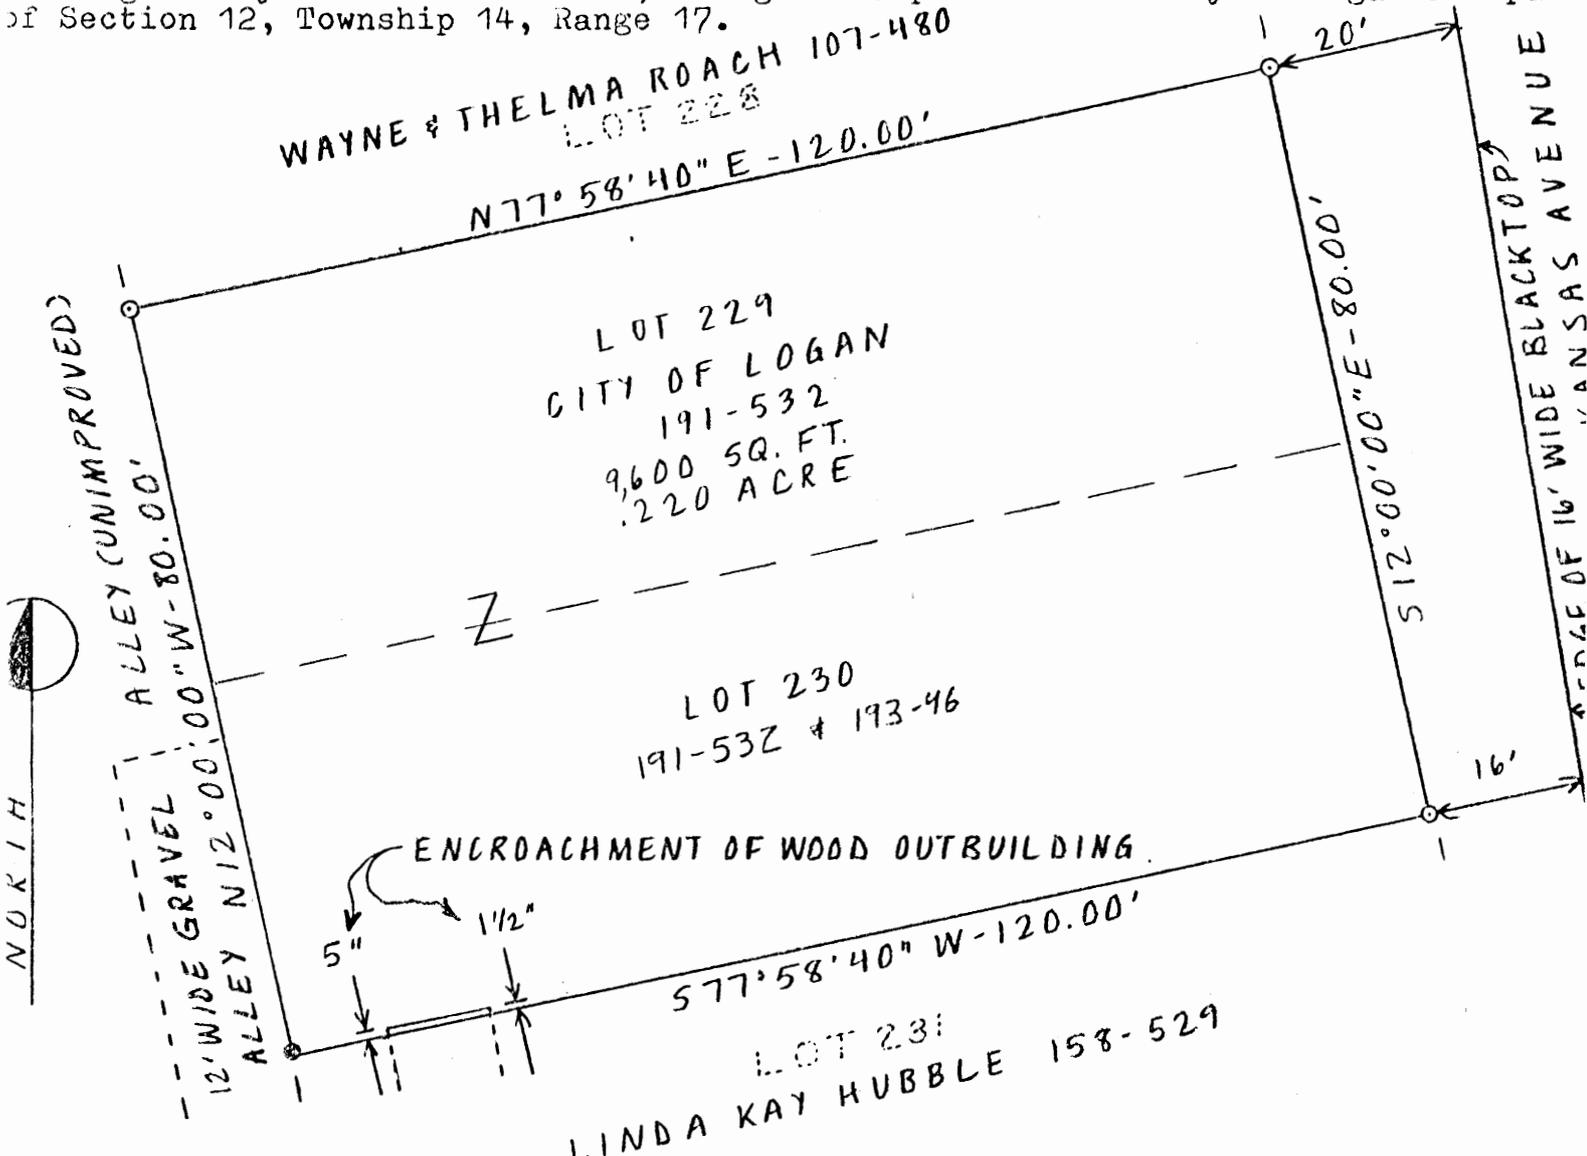

LEGEND

- 1" Iron pipe found
- 5/8" Iron pin with 1/4" plastic I.D. cap set

SCALE

1" = 20'

DATE

December 21, 1985

REFERENCES

- Tax maps
- Deed descriptions
- Previous surveys
- Existing monumentation
- Platted subdivision
- Existing public road

REFERENCE BEARING

West line of Lots 229 and 230 of Dicken's Allotment as North 12° 00' 00" West.

BUYER

Hocking Metropolitan Housing Authority

CERTIFIED TO

To all parties interested in title to premises surveyed.

I hereby certify that I personally made an actual survey of the premises shown on this plot plan on the 21st day of December, 1985; that this plot plan is a correct representation of the premises as determined by said survey. I further certify that there are no encroachments either way across any boundary line of the premises except as shown hereon.

Signed at Logan, Ohio, this 26th day of December, 1985.

Ray P. Verbo
 Registered Surveyor No. 6344

Approved - Mathematically
 Hocking County Engineer's office
 By *D. SMEN* Date *12-26-85*

Survey by: EARTH WORKS - Surveying, Engineering & Construction
 119 West Main Street, Logan, Ohio 43138 385-4260

SURVEY DESCRIPTION OF .220 ACRE LOTS 229 AND 230


OF DICKEN'S ALLOTMENT FOR HOCKING METROPOLITAN HOUSING AUTHORITY

Situated in Falls Township, Hocking County, Ohio; being all of Lots 229 and 230 of Dicken's Allotment as recorded in Plat Book B, Page 38, Hocking County Recorder's Office; being now a part of the City of Logan and part of Section 12, Township 14, Range 17; and being more particularly described as follows:

Beginning at a 1" iron pipe found at the Southwest corner of Lot 230; thence with the West line of Lots 230 and 229 North 12 degrees 00 minutes 00 seconds West a distance of 80.00 feet to a 5/8" iron pin set at the Northwest corner of Lot 229 which replaces a damaged 1-1/2" iron pipe found; thence with the North line of Lot 229 North 77 degrees 58 minutes 40 seconds East a distance of 120.00 feet to a 5/8" iron pin set at the Northeast corner of Lot 229; thence with the East line of Lots 229 and 230 South 12 degrees 00 minutes 00 seconds East a distance of 80.00 feet to a 5/8" iron pin set at the Southeast corner of Lot 230; thence with the South line of Lot 230 South 77 degrees 58 minutes 40 seconds West a distance of 120.00 feet to the point of beginning containing .220 acres more or less, subject to any private easements of record.

The above .220 acre survey is intended to describe all of Lots 229 and 230 of Dicken's Allotment as deeded to the City of Logan, deed reference Volume 191, Page 532, Hocking County Recorder's Office. This survey was based upon information obtained from tax maps, deed descriptions, previous surveys, existing monumentation, a platted subdivision, and an existing public road. The reference bearing for this survey is the West line of Lots 230 and 229 of Dicken's Allotment as North 12 degrees 00 minutes 00 seconds West. All iron pins set by this survey are capped by a 1-1/4" plastic identification cap. The above described property was surveyed by Larry P. Gerstner, Ohio Registered Surveyor No. 6344, on December 21, 1985.

Approved - Mathematically
Hocking County Engineer's office
By D. ENSM Date 12-26-85

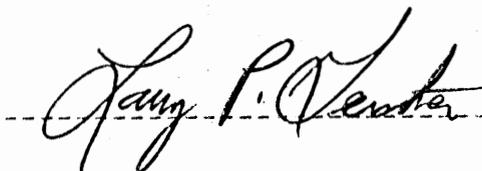

Survey by:
EARTH WORKS - Surveying, Engineering, and Construction
119 West Main Street, Logan, Ohio 43138 385-4260

tb Falls Twp.
Logan City Sec. 12
Map 38 Lots 306 & 307, 308



Cannon Land Surveying

7945 Twp. Rd. 114 NE
New Lexington, Ohio 43764
(740) 342-2835



Bearings Shown Hereon are to an Assumed Meridian and Are Used to Denote Angles Only.
Data References: U.S.G.S. Maps, Tax Maps, Deed Descriptions, and Existing Monumentation.

This Survey is Subject to any Facts That May be Disclosed by a Full and Accurate Title Search.

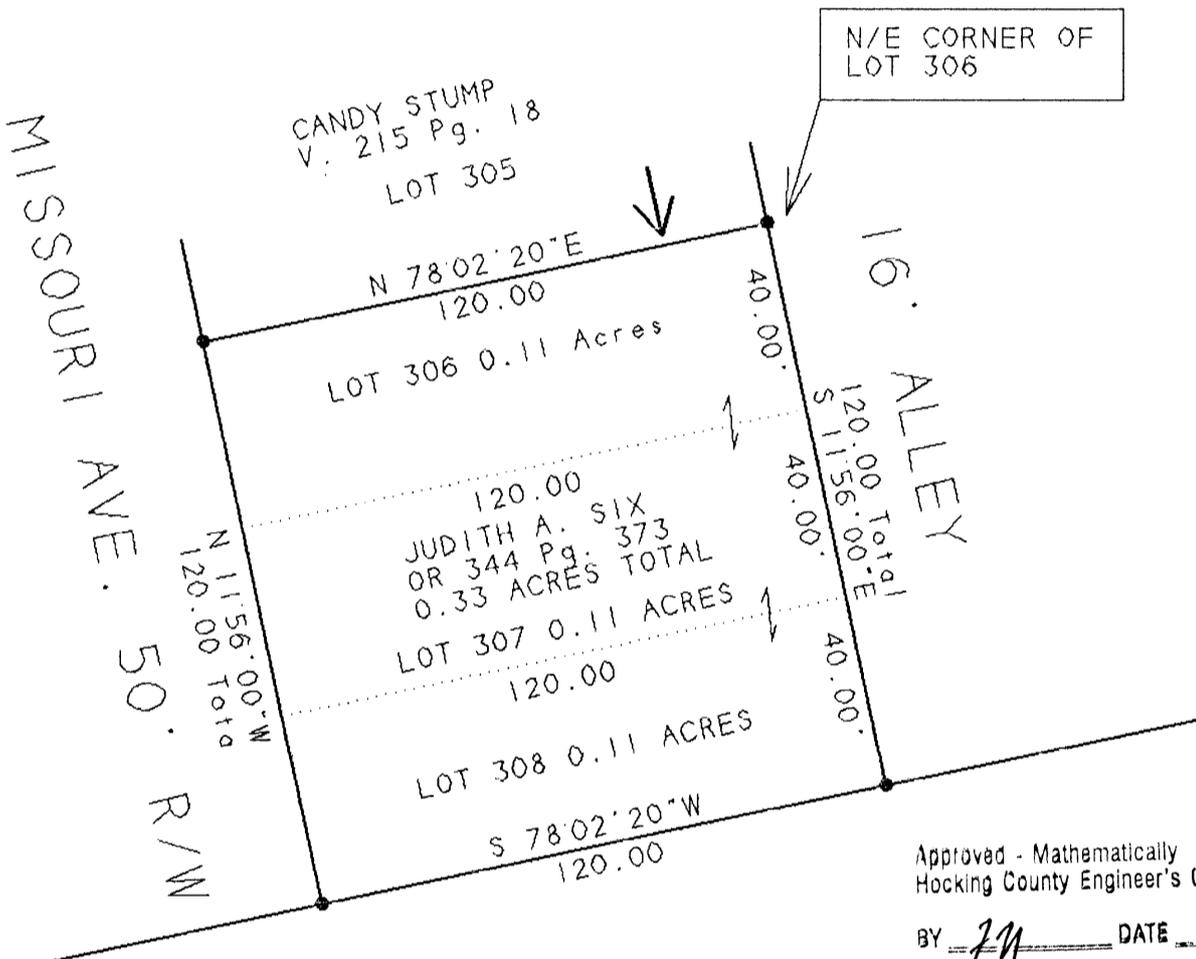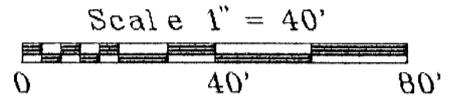

JUDITH SIX & DIANE GOSS
OR 97 Pg. 504
OR 91 Pg. 250
OR 89 Pg. 580
OR 339 Pg. 345
OR 344 Pg. 373
3.14 ACRES

Kevin Cannon
Reg. # 7224

5/15/06
Date

Legend

- Iron Pin Set
5/8" Rebar 30" Long
Stamped CLS # 7224
- Iron Pin Found
- ⊗ Post
- ▲ R.R. Spike Set
- △ R.R. Spike Found
- ⊙ Drilled Hole 5/8"
- Stone Found
- PK Nail Set
- ⊙ PK Nail Found
- ××× Fence
- ➔ Basis Of Bearings

Survey For: WENDY BROOKS
State: Ohio
County: HOCKING
Township: FALLS
T- 14 R- 17 Lot: ALL OF 306, 307 & 308
Section: 12
City or Village: Logan
Subdivision: DICKEN ALLOTMENT
PLAT CABINET 1, SHEETS 2B & 3A

CANNON LAND SURVEYING
7945 TWP. RD. 114 NE
NEW LEXINGTON, OHIO 43764
(740) 342-2835

DEED DESCRIPTION

Situated in the State of Ohio, County of Hocking, Township of Hocking, T-14, R-17, being a resurvey of Judith A. Six OR 344 Pg. 373, being part of Section 12, being a resurvey of Lots 306, 307 & 308 of Dicken Allotment, Plat Cabinet 1, Sheet 2B & 3A in the city of Logan, and more particularly described as follows:

Beginning at an iron pin set at the Northeast Corner of Lot 306; thence along the East Line of Lots 306, 307 & 308 South 11 Degrees 56 Minutes 00 Seconds East 120.00 feet to an iron pin set, passing the Southeast Corner of Lots 306 at 40.00 feet & the Southeast Corner of Lot 307 at 80.00 feet; thence along the South Line of Lot 308 along Judith Six & Diane Goss OR 97 Pg. 504, OR 91 Pg. 250, OR 89 Pg. 580, OR 339 Pg. 345 & OR 344 Pg. 373 South 78 Degrees 02 Minutes 20 Seconds West 120.00 feet to an iron pin set; thence along the West Line of Lots 308, 307 & 306 North 11 Degrees 56 Minutes 00 Seconds West 120.00 feet to an iron pin set, passing the Northwest Corner of Lot 308 at 40.00 feet and the Northwest Corner of Lot 307 at 80.00 feet; thence along the North Line of Lot 306 along Candy Stump Vol. 215 Pg. 305 North 78 Degrees 02 Minutes 20 Seconds East 120.00 feet to the place of beginning, containing 0.11 acres in Lot 306, 0.11 acres in Lot 307 & 0.11 acres in Lot 308, containing 0.33 acres total, more or less, subject to all legal highways and easements.

See plat attached.

Iron pins set are 5/8 inch rebar 30 inches long with plastic identification caps stamped CLS # 7224.

Bearings are based on the North Line of Lot 306 as being North 78 Degrees 02 Minutes 20 Seconds East.

This description was written from a survey made by Kevin Cannon 7224, May 15, 2006.



Kevin Cannon
Reg. No. 7224

5/15/06

Date

Approved - Mathematically
Hocking County Engineer's Office

BY  DATE 5-17-06



38 LOGAN CITY
KANSAS AVE

FROM RECORD
OF SURVEYS BOOK
#1 PAGE 271
HOCKING COUNTY
ENGINEERS
OFFICE

AVE.

COLORADO

AVE.

ADO

OHIO

401	210	401	120'	232	401
	211			231	
	212			230	
	213			229	
	214			228	
	215			227	
				226	
				225	
			120'	224	
				223	
				222	
				12214'	

209
120'

AVE.

IS

401	233	401	120'	233	401
	234			234	
	235			235	
	236			236	
	237			237	
	238			238	
	239			239	
	240			240	
	241			241	
	242			242	
	244			244	
	245			245	
	246			246	
	247			247	
	248			248	
	249			249	
	250			250	
	251			251	

120'

AVE

N 26° 13' E

AVE.


'RI

MISSOURI

SURVEY PLAT OF .046 ACRE EASEMENT OVER LOTS 240, 241 AND 242

OF DICKEN'S ALLOTMENT FOR HOCKING METROPOLITAN HOUSING AUTHORITY

Situated in Falls Township, Hocking County, Ohio; being part of Lots 240, 241 and 242, all of Dicken's Allotment as recorded in Plat Book B, Page 38, Hocking County Recorder's Office; being now a part of the City of Logan and part of Section 12, Township 14, Range 17.

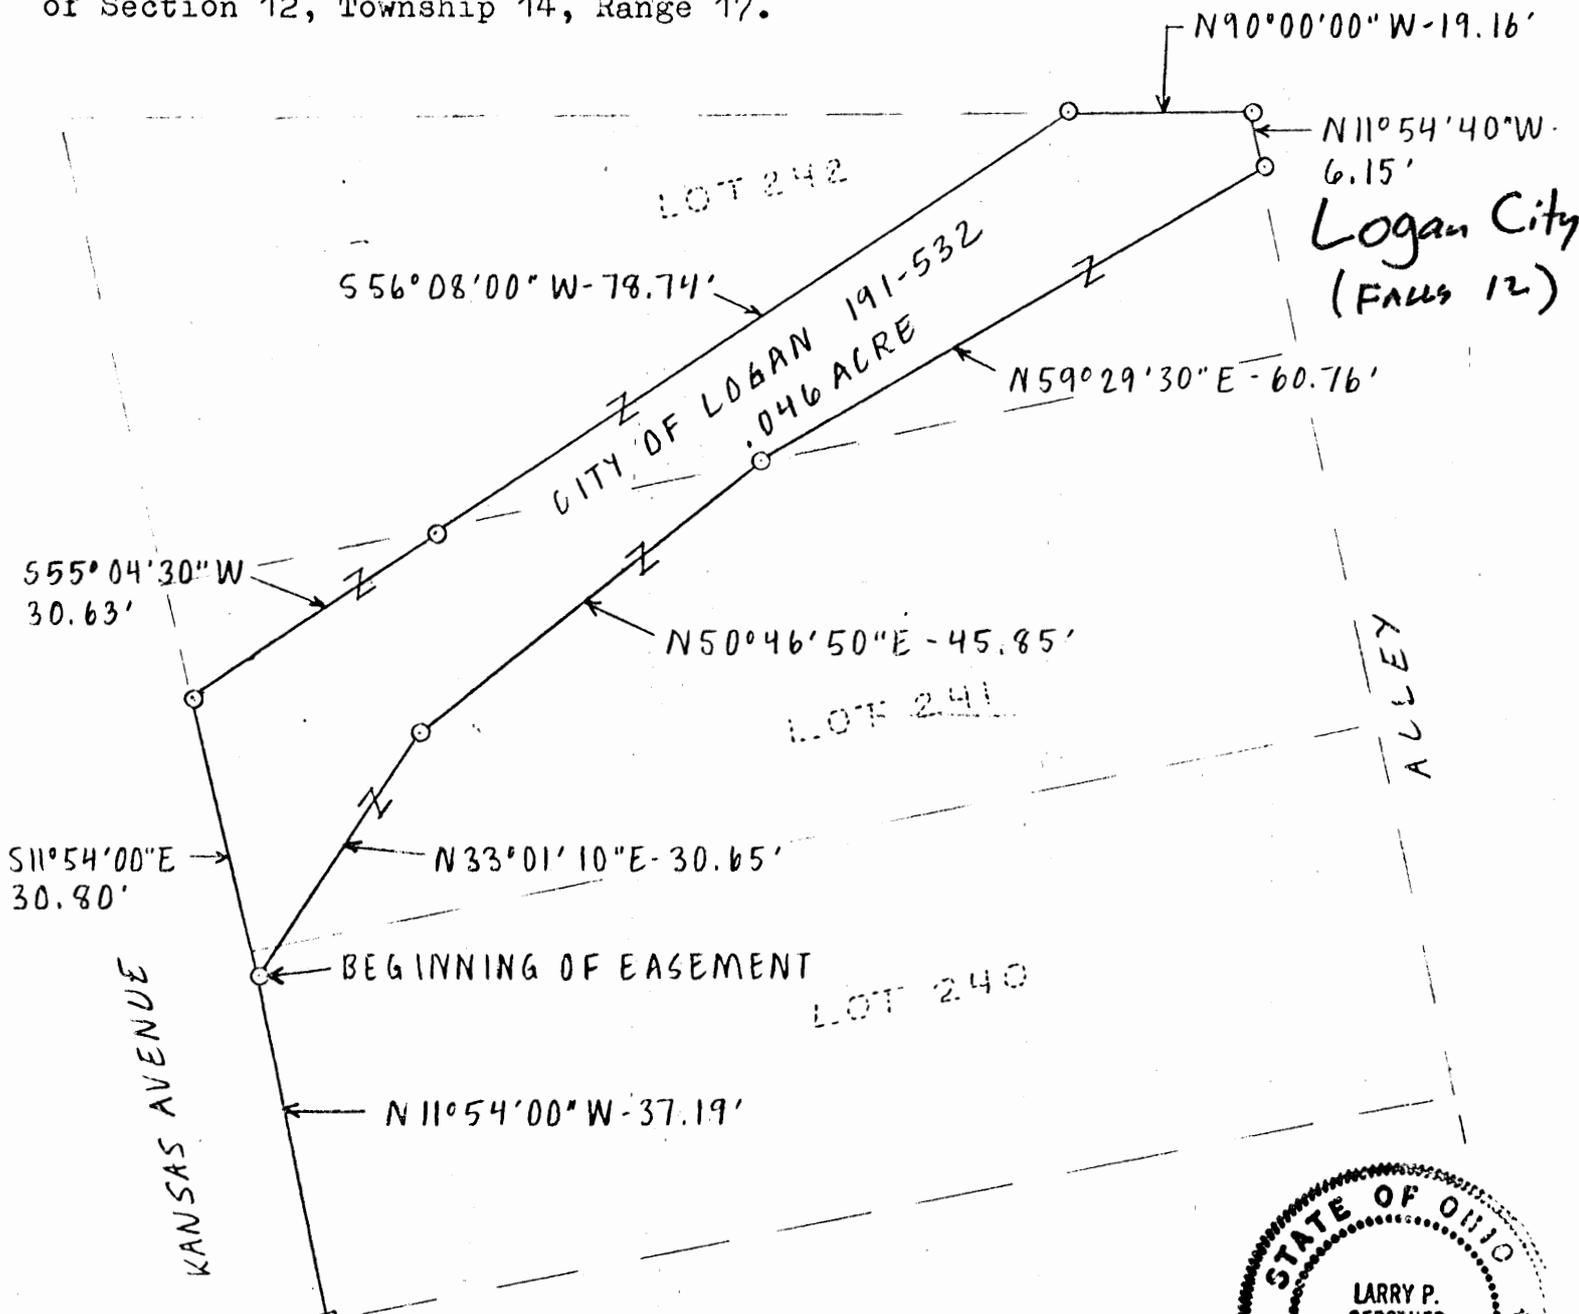


LEGEND

- 5/8" Iron pin with 1/4" plastic I.D. cap set
- 1 1/2" Iron bolt found

SCALE

1" = 20'

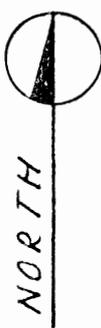

REFERENCES

- Tax maps
- Deed descriptions
- Previous surveys
- Existing monumentation
- Platted subdivision
- Existing public road

REFERENCE BEARING

West line of Lots 240, 241 and 242 of Dicken's Allotment as North $11^{\circ}54'00''$ West.

I hereby certify that an actual survey was made under my supervision of the premises shown hereon on the 15th day of March 1986 and that the plat is a correct representation of the premises as described by said survey.

Approved - Mathematically
 Hocking County Engineer's office.
 By D. Guy Date 3-18-86
 *see Easement Transferred
 5-20-86

Larry P. Gerstner
 Registered Surveyor No. 6344

Survey by: **EARTH WORKS - Surveying, Engineering & Construction**
 119 West Main Street, Logan, Ohio 43138 385-4260

SURVEY DESCRIPTION OF .046 ACRE EASEMENT OVER LOTS 240, 241 AND 242
OF DICKEN'S ALLOTMENT FOR HOCKING METROPOLITAN HOUSING AUTHORITY

Situated in Falls Township, Hocking County, Ohio; being part of Lots 240, 241 and 242, all of Dicken's Allotment as recorded in Plat Book B, Page 38, Hocking County Recorder's Office; being now a part of the City of Logan and part of Section 12, Township 14, Range 17; being an easement of ingress and egress; and being more particularly described as follows:

Commencing for reference at a 1-1/2" iron bolt found at the Southwest corner of Lot 240; thence with the West line of Lot 240 North 11 degrees 54 minutes 00 seconds West a distance of 37.13 feet to a 5/8" iron pin set and being the point of Beginning of the surveyed easement to be described; thence North 33 degrees 01 minutes 10 seconds East a distance of 30.65 feet to a 5/8" iron pin set; thence North 50 degrees 46 minutes 50 seconds East a distance of 45.85 feet to a 5/8" iron pin set; thence North 53 degrees 29 minutes 30 seconds East a distance of 60.76 feet to a 5/8" iron pin set on the East line of Lot 242; thence with the East line of Lot 242 North 11 degrees 54 minutes 40 seconds West a distance of 6.15 feet to a 5/8" iron pin set in an existing roadway and being the Northeast corner of Lot 242; thence with the North line of Lot 242 North 90 degrees 00 minutes 00 seconds West a distance of 19.16 feet to a 5/8" iron pin set; thence South 56 degrees 08 minutes 00 seconds West a distance of 78.74 feet to a 5/8" iron pin set; thence South 53 degrees 04 minutes 30 seconds West a distance of 30.63 feet to a 5/8" iron pin set on the West line of Lot 241; thence with the West line of Lots 241 and 240 South 11 degrees 54 minutes 00 seconds East a distance of 30.80 feet to the point of beginning containing .046 acres more or less, subject to any private easements of record.

The above .046 acre surveyed easement of ingress and egress is intended to describe part of Lots 240, 241 and 242 of Dicken's Allotment as deeded to the City of Logan, deed reference Volume 131, Page 532, Hocking County Recorder's Office. This survey was based upon information obtained from tax maps, deed descriptions, previous surveys, existing monumentation, a platted subdivision, and an existing public road. The reference bearing for this survey is the West line of Lots 240, 241 and 242 of Dicken's Allotment as North 11 degrees 54 minutes 00 seconds West. All iron pins set by this survey or previously set are capped by a 1-1/4" plastic identification cap. The above described property was surveyed by Larry P. Gerstner, Ohio Registered Surveyor No. 6344, on March 15, 1986.




Larry P. Gerstner

Approved - Mathematically
Hocking County Engineer's office
By *D. G. M.* Date *5-18-86*
** 500 Easement Transferred*
5-20-86

Survey by:
EARTH WORKS - Surveying, Engineering, and Construction
119 West Main Street, Logan, Ohio 43138 385-4260

OF DICKEN'S ALLOTMENT FOR HOCKING METROPOLITAN HOUSING AUTHORITY

Situated on Kansas Avenue, in Falls Township, Hocking County, Ohio; being all Lots 240 and 241 of Dicken's Allotment as recorded in Flat Book B, Page 38, Hocking County Recorder's Office; being now a part of the City of Logan and part of Section 12, Township 14, Range 17.

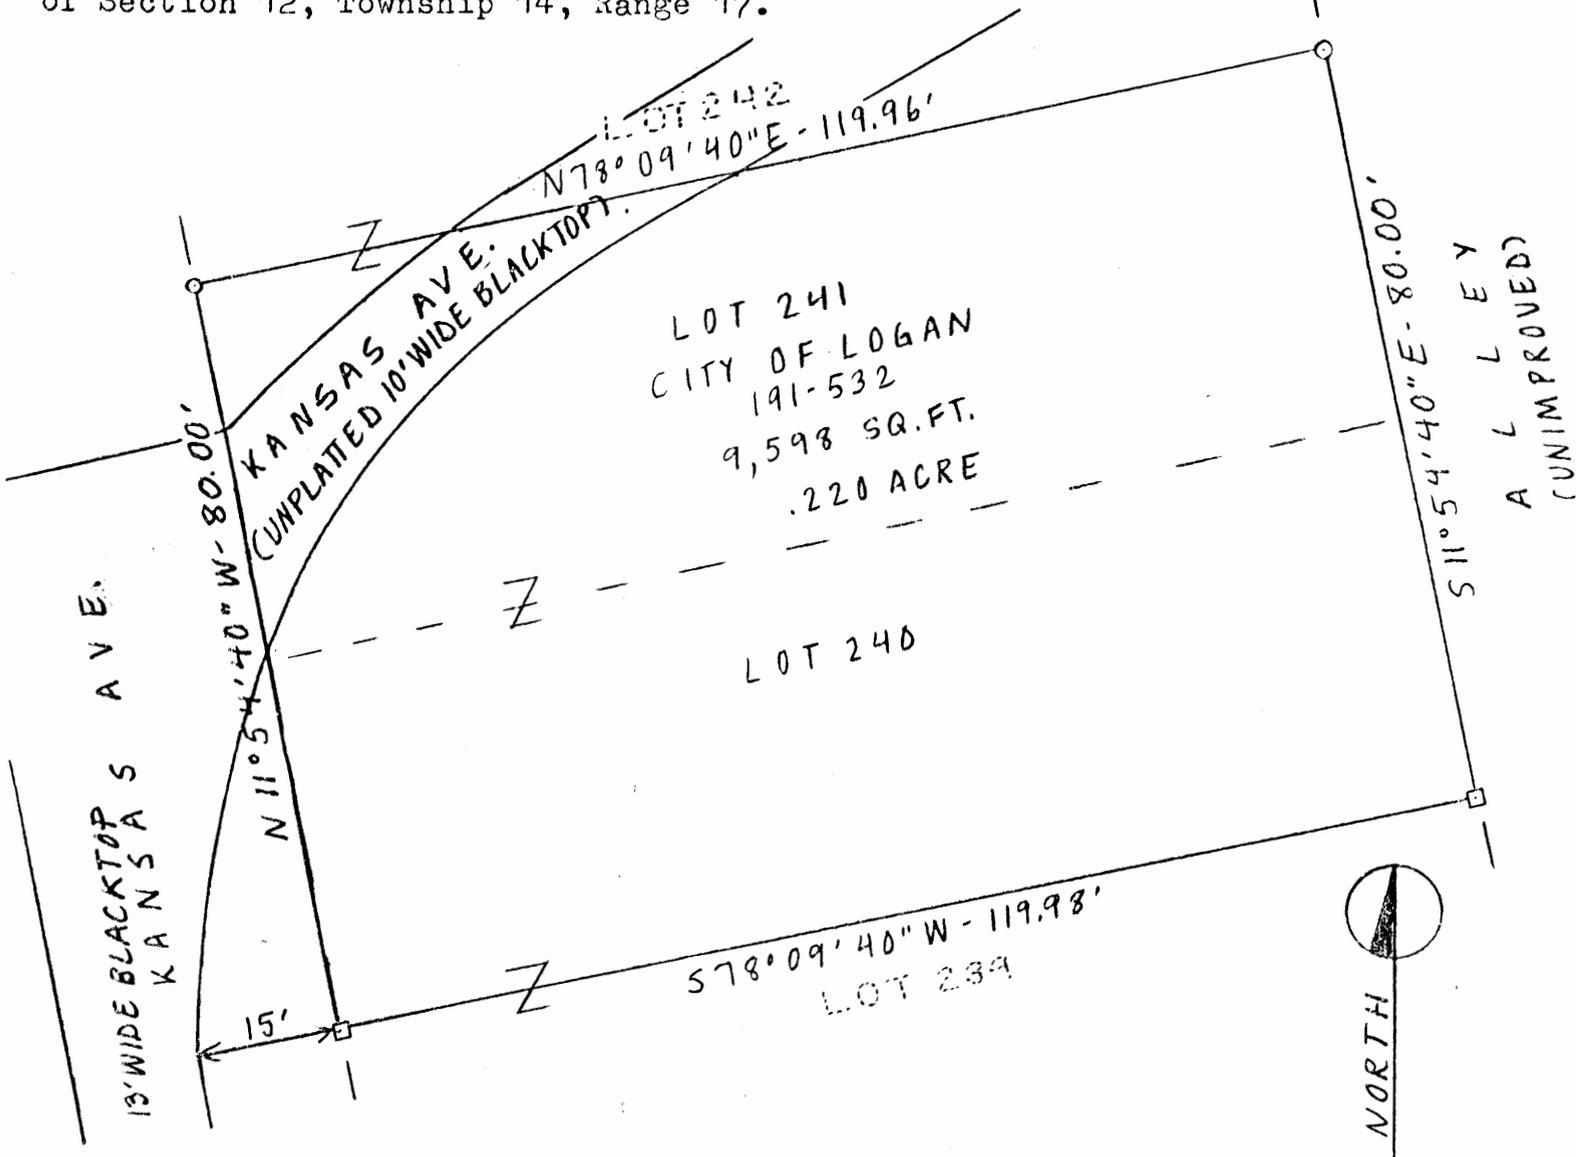

LEGEND

- 1 1/2" Iron bolt found
- 5/8" Iron pin with 1/4" plastic I.D. cap set

REFERENCES

- Tax maps
- Deed descriptions
- Previous surveys
- Existing monumentation
- Platted subdivision
- Existing public road

SCALE

1" = 20'

DATE

December 21, 1985

REFERENCE BEARING

West line of Lots 240 and 241 of Dicken's Allotment as North 11° 54' 00" West.

BUYER

Hocking Metropolitan Housing Authority

CERTIFIED TO

To all parties interested in title to premises surveyed.

I hereby certify that I personally made an actual survey of the premises shown on this plot plan on the 21st day of December, 1985; that this plot plan is a correct representation of the premises as determined by said survey. I further certify that there are no encroachments either way across any boundary line of the premises except as shown hereon.

Signed at Logan, Ohio, this 26th day of December, 1985.



Larry P. Gerstner
 Registered Surveyor No. 6344

Approved - Mathematically
 Hocking County Engineer
 By *D. ENSM* Date *12-26-85*

SURVEY DESCRIPTION OF .220 ACRE LOTS 240 AND 241

OF DICKEN'S ALLOTMENT FOR HOCKING METROPOLITAN HOUSING AUTHORITY

Situated in Falls Township, Hocking County, Ohio; being all of Lots 240 and 241 of Dicken's Allotment as recorded in Plat Book B, Page 38, Hocking County Recorder's Office; being now a part of the City of Logan and part of Section 12, Township 14, Range 17; and being more particularly described as follows:

Beginning at a 1-1/2" iron bolt found at the Southwest corner of Lot 240; thence with the West line of Lots 240 and 241 North 11 degrees 54 minutes 40 seconds West a distance of 80.00 feet to a 5/8" iron pin set at the Northwest corner of Lot 241; thence with the North line of Lot 241 North 78 degrees 09 minutes 40 seconds East a distance of 119.36 feet to a 5/8" iron pin set at the Northeast corner of Lot 241; thence with the East line of Lots 241 and 240 South 11 degrees 54 minutes 40 seconds East a distance of 80.00 feet to a 1-1/2" iron bolt found at the Southeast corner of Lot 240; thence with the South line of Lot 240 South 78 degrees 09 minutes 40 seconds West a distance of 119.38 feet to the point of beginning containing .220 acres more or less, subject to any private easements of record.

The above .220 acre survey is intended to describe all of Lots 240 and 241 of Dicken's Allotment as deeded to the City of Logan, deed reference Volume 191, Page 532, Hocking County Recorder's Office. This survey was based upon information obtained from tax maps, deed descriptions, previous surveys, existing monumentation, a platted subdivision, and an existing public road. The reference bearing for this survey is the West line of Lots 240 and 241 of Dicken's Allotment as North 11 degrees 54 minutes 00 seconds West. All iron pins set by this survey are capped by a 1-1/4" plastic identification cap. The above described property was surveyed by Larry P. Gerstner, Ohio Registered Surveyor No. 6344, on December 21, 1985.



Larry P. Gerstner

Survey by:

EARTH WORKS - Surveying, Engineering, and Construction
119 West Main Street, Logan, Ohio 43138 385-4260


Approved - Mathematically
Hocking County Engineer's office
By D. F. N. S. M. Date 12-26-85

SURVEY PLAT OF .195 ACRE PART OF LOTS 240 AND 241

OF DICKEN'S ALLOTMENT FOR HOCKING METROPOLITAN HOUSING AUTHORITY

Situated on Kansas Avenue, in Falls Township, Hocking County, Ohio; being part of Lots 240 and 241, both of Dicken's Allotment as recorded in Plat Book B, Page 38, Hocking County Recorder's Office; being now a part of the City of Logan and part of Section 12, Township 14, Range 17. **Logan City (Falls 12)**

Approved - Mathematically *
Hocking County Engineer's office
By D. G. M. Date 3-18-86
* PENDING City Planning Commission Approval.

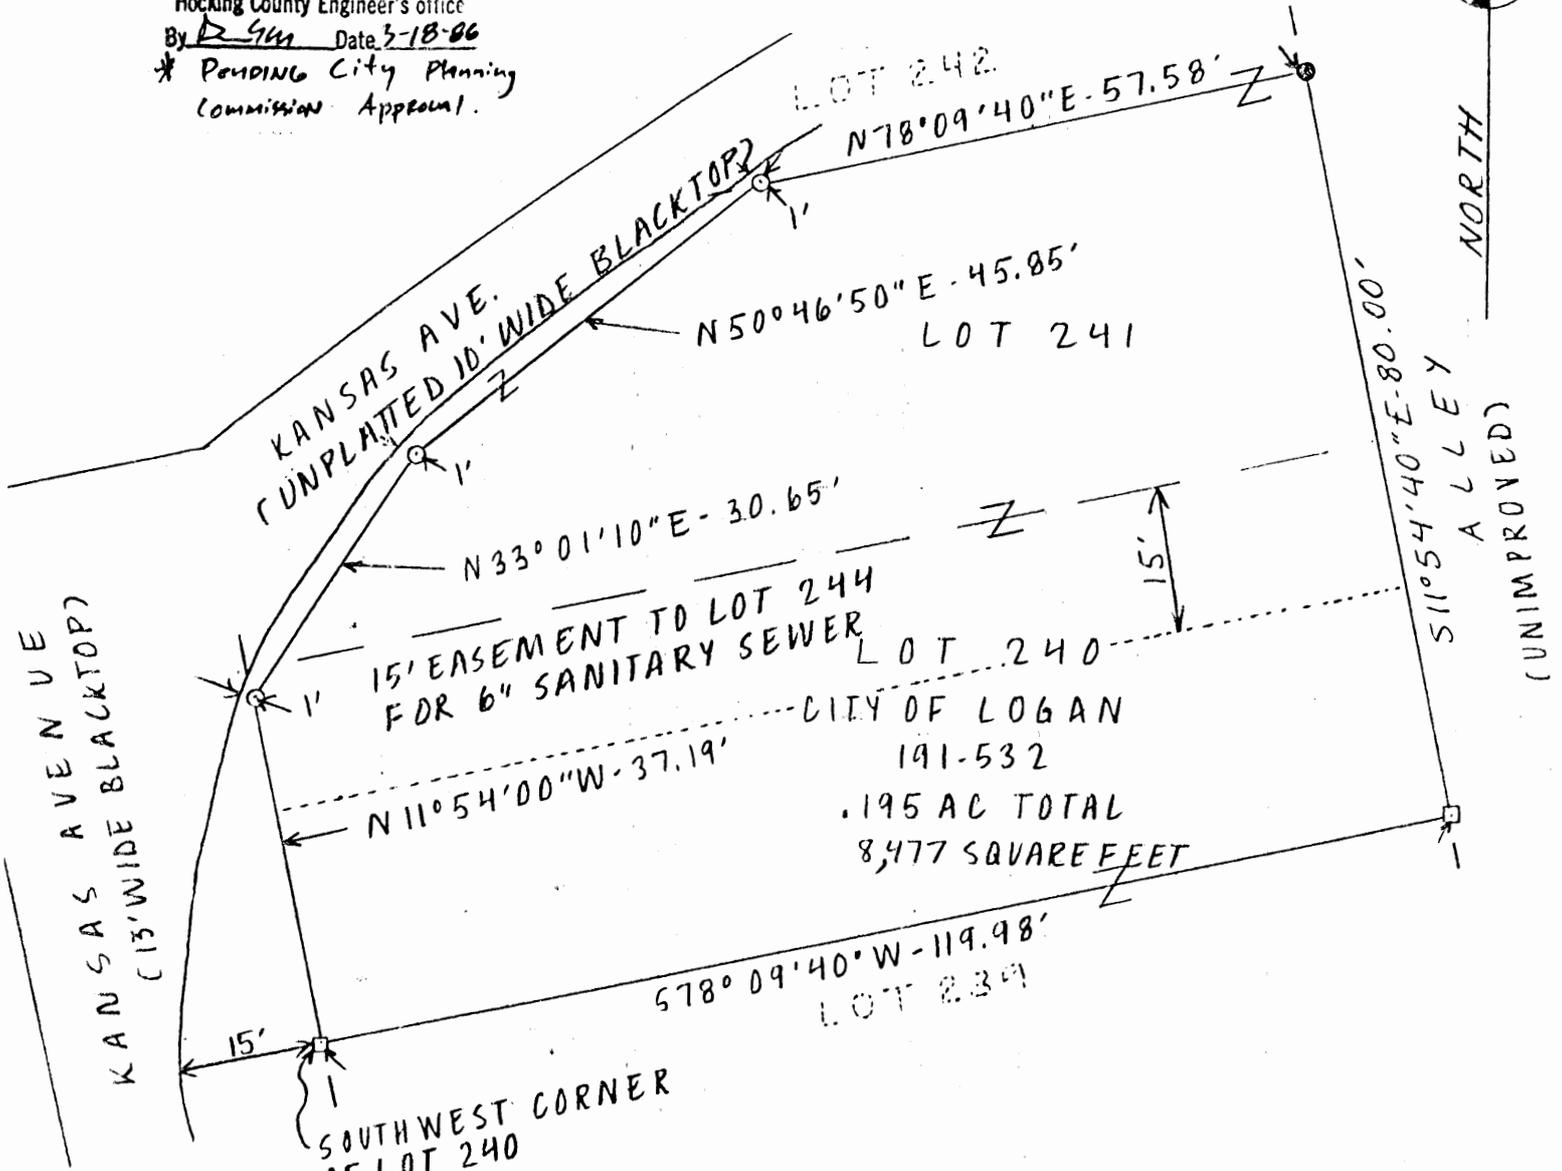


LEGEND

- 1 1/2" Iron bolt found
- 5/8" Iron pin previously set
- 5/8" Iron pin with 1 1/4" plastic I.D. cap set

REFERENCES

- Tax maps
- Deed descriptions
- Previous surveys
- Existing monumentation
- Platted subdivision
- Existing public road

SCALE

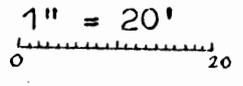

DATE

March 15, 1986

REFERENCE BEARING

West line of Lots 240 and 241 of Dicken's Allotment as North 11°54'00" West.

BUYER

Hocking Metropolitan Housing Authority

CERTIFIED TO

To all parties interested in title to premises surveyed.

I hereby certify that I personally made an actual survey of the premises shown on this plot plan on the 15th day of March, 1986; that this plot plan is a correct representation of the premises as determined by said survey. I further certify that there are no encroachments either way across any boundary line of the premises except as shown hereon.

Signed at Logan, Ohio, this 18th day of March, 1986.

Larry P. Gerstner
Registered Surveyor No. 6344



SURVEY DESCRIPTION OF .195 ACRE PART OF LOTS 240 AND 241
OF DICKEN'S ALLOTMENT FOR HOCKING METROPOLITAN HOUSING AUTHORITY

Situated in Falls Township, Hocking County, Ohio; being part of Lots 240 and 241, both of Dicken's Allotment as recorded in Plat Book B, Page 38, Hocking County Recorder's Office; being now a part of the City of Logan and part of Section 12, Township 14, Range 17; and being more particularly described as follows:

Beginning at a 1-1/2" iron bolt found at the Southwest corner of Lot 240; thence with the West line of Lot 240 North 11 degrees 54 minutes 00 seconds West a distance of 37.19 feet to a 5/8" iron pin set; thence North 33 degrees 01 minutes 10 seconds East a distance of 30.65 feet to a 5/8" iron pin set; thence North 50 degrees 46 minutes 50 seconds East a distance of 45.85 feet to a 5/8" iron pin set on the North line of Lot 241; thence with the North line of Lot 241 North 78 degrees 09 minutes 40 seconds East a distance of 57.58 feet to a 5/8" iron pin previously set at the Northeast corner of Lot 241; thence with the East line of Lots 241 and 240 South 11 degrees 54 minutes 40 seconds East a distance of 80.00 feet to a 1-1/2" iron bolt found at the Southeast corner of Lot 240; thence with the South line of Lot 240 South 78 degrees 09 minutes 40 seconds West a distance of 119.98 feet to the point of beginning containing .195 acres more or less, subject to any private easements of record.

The above .195 acre survey is intended to describe part of Lots 240 and 241 of Dicken's Allotment as deeded to the City of Logan, deed reference Volume 191, Page 532, Hocking County Recorder's Office. This survey was based upon information obtained from tax maps, deed descriptions, previous surveys, existing monumentation, a platted subdivision, and an existing public road. The reference bearing for this survey is the West line of Lots 240 and 241 of Dicken's Allotment as North 11 degrees 54 minutes 00 seconds West. All iron pins set by this survey or previously set are capped by a 1-1/4" plastic identification cap. The above described property was surveyed by Larry P. Gerstner, Ohio Registered Surveyor No. 6344, on March 15, 1986.



Larry P. Gerstner

Survey by:
EARTH WORKS - Surveying, Engineering, and Construction
119 West Main Street, Logan, Ohio 43138 385-4260

Approved - Mathematically *
Hocking County Engineer's office
By DGM Date 3-18-86
* Pending City Planning
Commission Approval

SURVEY DESCRIPTION OF A 3.144 ACRE TRACT FOR JOHN GOSS

Situated in the City of Logan, Falls Township, Hocking County, Ohio; being part of Section 12, Township 14, Range 17; being Grandview Park of the Dicken's Allotment as recorded in Plat Book B, Page 38, Hocking County Recorder's Office; and being more particularly described as follows:

Beginning at a 5/8" iron pin set at the Southwest corner of Lot 285 of said Dicken's Allotment which is the Northwest corner of said Grandview Park; thence with the South lines of Lots 285, 308, 322, and 398 of said Dicken's Allotment North 78 degrees 02 minutes 20 seconds East a distance of 546.03 feet to a 5/8" iron pin set on the East line of Falls Township Section 12 and the City of Logan Corporation Limits at the Northeast corner of said Grandview Park;

thence with the East line of Falls Township Section 12 and the City of Logan Corporation Limits South 00 degrees 00 minutes 00 seconds East a distance of 326.11 feet to a 5/8" iron pin set at the Southeast corner of said Grandview Park;

thence leaving the East line of Falls Township Section 12 and the City of Logan Corporation Limits North 88 degrees 56 minutes 30 seconds West a distance of 491.07 feet to a 5/8" iron pin set at the Southwest corner of said Grandview Park;

thence North 11 degrees 57 minutes 40 seconds West a distance of 208.40 feet to the point of beginning, containing 3.144 acres more or less and subject to any public or private easements of record.

The above 3.144 acre survey is intended to describe all of Grandview Park of said Dicken's Allotment with current ownership being uncertain, but as last deeded to James Dicken by deed reference Volume 31, Page 440, Hocking County Recorder's Office. This survey was based upon information obtained from tax maps, deed descriptions, previous surveys, and existing monumentation. The reference bearing for this survey is the East line of Falls Township Section 12 as South 0 degrees 00 minutes 00 seconds East. Bearings are based upon an assumed meridian and are to denote angles only. All iron pins set by this survey are 5/8" by 30" and are capped by a 1-1/4" plastic identification cap stamped LPG-6344. The above described property was surveyed by Larry P. Gerstner, Ohio Registered Surveyor No. 6344, on June 5, 1996.



Approver: Mathematical
Hocking County Recorder's Office
By: JY Date: 6-6-96

A handwritten signature of Larry P. Gerstner in cursive, written over a horizontal line.

Survey by:
Larry P. Gerstner - Engineering and Surveying
119 West Main Street, Logan, Ohio 43138 385-4260

DESCRIPTION OF SURVEY FOR MR. JERRY LARGENT

TRACT "A"

Being all of Lot No. 255 and part of Lot No. 256 of Dicken's Allotment of the City Of Logan as delineated in Plat Bk. "B", Pg. 38, Hocking Co. Records Office, situated in Sec. 12 of Falls Twp., T-14N, R-17W, Hocking Co., Ohio, and being more particularly described as follows:

Beginning at an iron pin set on the NW corner of said Lot No. 255;

Thence, with the north line of said lot and an extension thereof, N 78° 00' 00" E a distance of 63.99 ft. to an iron pin set;

Thence, with a new line, S 12° 00' 00" E a distance of 120.00 ft. to an iron pin set on the north line of Ohio Ave.;

Thence, with said north line, S 78° 00' 00" W a distance of 63.99 ft. to an iron pin set on the SW corner of Lot No. 255;


Thence, with the west line of said Lot, N 12° 00' 00" W a distance of 120.00 ft. to the place of beginning, containing 7678.8 ft.², more or less, and being subject to all valid easements.

Cited bearings are based on the west right-of-way line of Missouri Ave. as running S 12° 00' 00" E.

All iron pins described as being set are 1/2" X 30" with an attached plastic identification cap.

The above description is the result of an actual survey made by Michael P. Berry, Ohio Registered Surveyor No. 6803, on November 11, 1994.

Approved - Mathematically
Hocking County Engineer's office
By *fy CK* Date 11-18-94
Pending City Planning
Comm. Approval
Approval Given 11-15-94

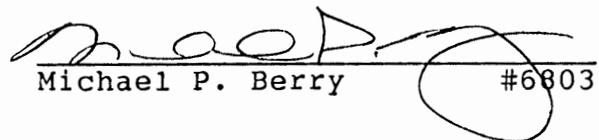
Michael P. Berry #6803

DESCRIPTION OF SURVEY FOR MR. JERRY LARGENT

TRACT "B"

Being all of Lot No. 257 and part of Lot No. 256 of Dicken's Allotment of the City Of Logan as delineated in Plat Bk. "B", Pg. 38, Hocking Co. Recorders Office, situated in Sec. 12 of Falls Twp., T-14N, R-17W, Hocking Co., Ohio, and being more particularly described as follows:

Beginning at an iron pin set on the NE corner of said Lot No. 257;

Thence, with the east line of Lot No. 257, S 12° 00' 00" E a distance of 120.00 ft. to an iron pin set on the SE corner of said Lot;

Thence, with the north line of Ohio Ave., S 78° 00' 00" W a distance of 63.99 ft. to an iron pin set;

Thence, with a new line, N 12° 00' 00" W a distance of 120.00 ft. to an iron pin set on the north line of Lot No. 256;

Thence, with said north line and an extension thereof, N 78° 00' 00" E a distance of 63.99 ft. to the place of beginning, containing 7678.8 ft.², more or less, and being subject to all valid easements.

Cited bearings are based on the west right-of-way line of Missouri Ave. as running S 12° 00' 00" E.

All iron pins described as being set are 1/2" X 30" with an attached plastic identification cap.

The above description is the result of an actual survey made by Michael P. Berry, Ohio Registered Surveyor No. 6803, on November 11, 1994.

Approved - Mathematically
Hocking County Engineer's office
By *[Signature]* Date 11-18-94
CK
Pending City Planning
Comm. Approval
Approval Given 11-15-94


[Signature]
Michael P. Berry #6803

1" = 30'
 O = 1/8" IRON PIN SET

PLAT SHOWING LOTS 243-247 AND
 LOTS 349-354 IN "DICKEN'S ADDITION"
 SITUATE IN SECTION 12, T14, R17,
 FALLS TOWNSHIP, HOCKING COUNTY,
 STATE OF OHIO


I HEREBY CERTIFY THAT AN ACTUAL SURVEY WAS MADE UNDER MY
 SUPERVISION OF THE PREMISES SHOWN HEREON ON THE 3RD DAY
 OF APRIL 1978; AND THAT THE PLAT IS A CORRECT
 REPRESENTATION OF THE PREMISES AS DETERMINED BY SAID SURVEY.

George F. Seymour
 REGISTERED SURVEYOR No. 6044

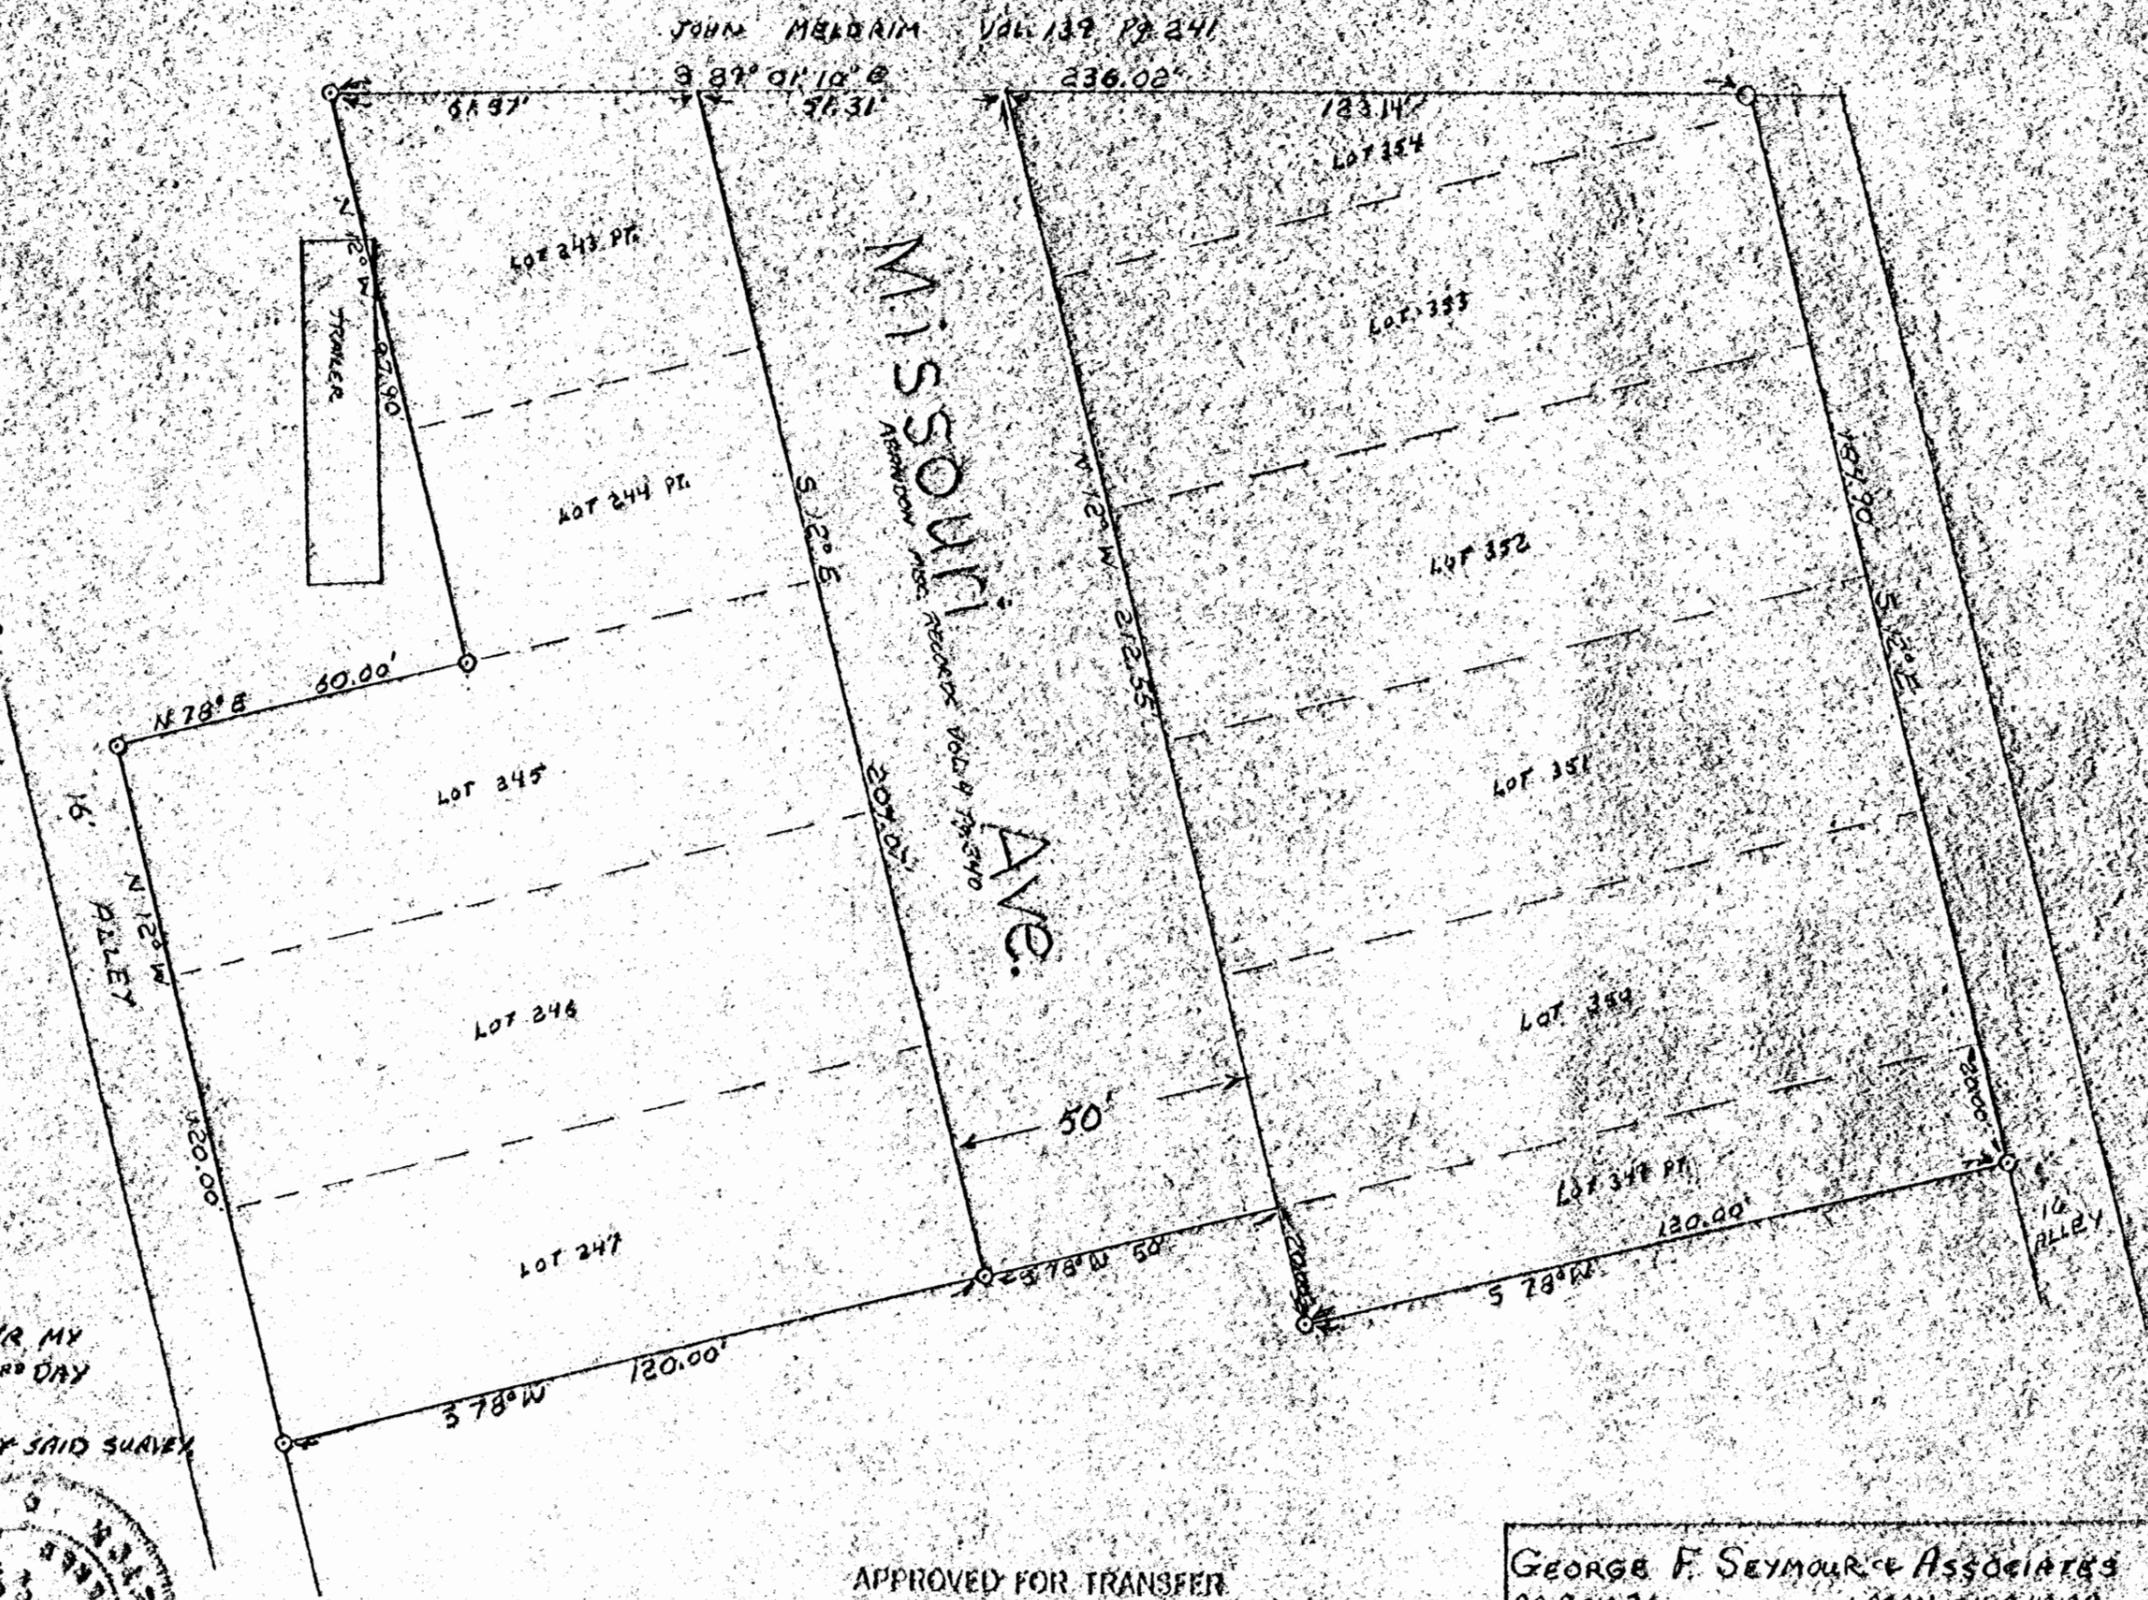


APPROVED FOR TRANSFER
 BY THE HOCKING COUNTY
 ENGINEER'S OFFICE
 BY (S) DATE 4-11-78

GEORGE F. SEYMOUR & ASSOCIATES
 P.O. BOX 26 LOGAN, OHIO 43138
 380-4347
 SURVEY FOR DON STORCK

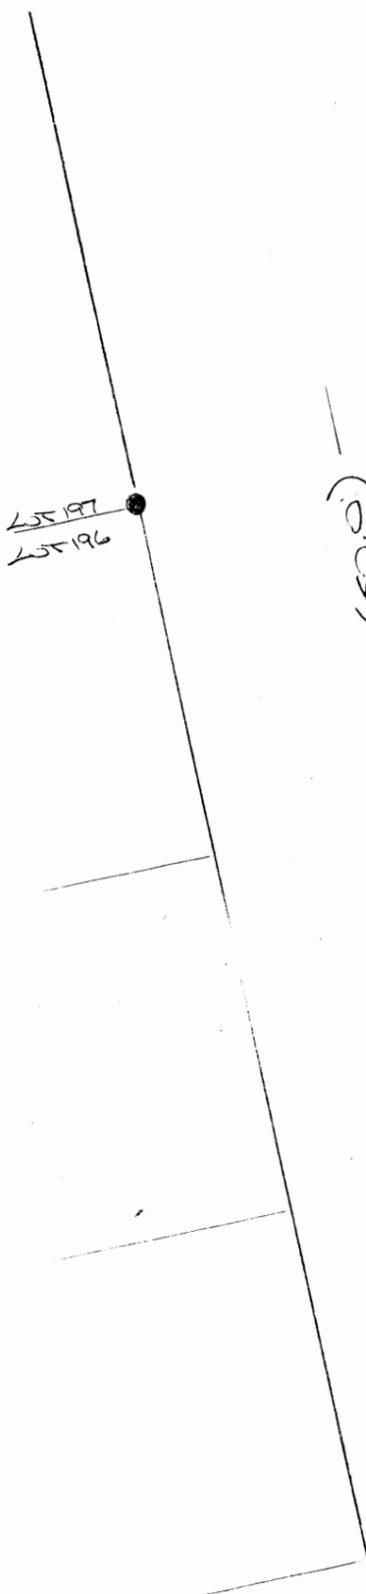

KANSAS AVE. (50.0)

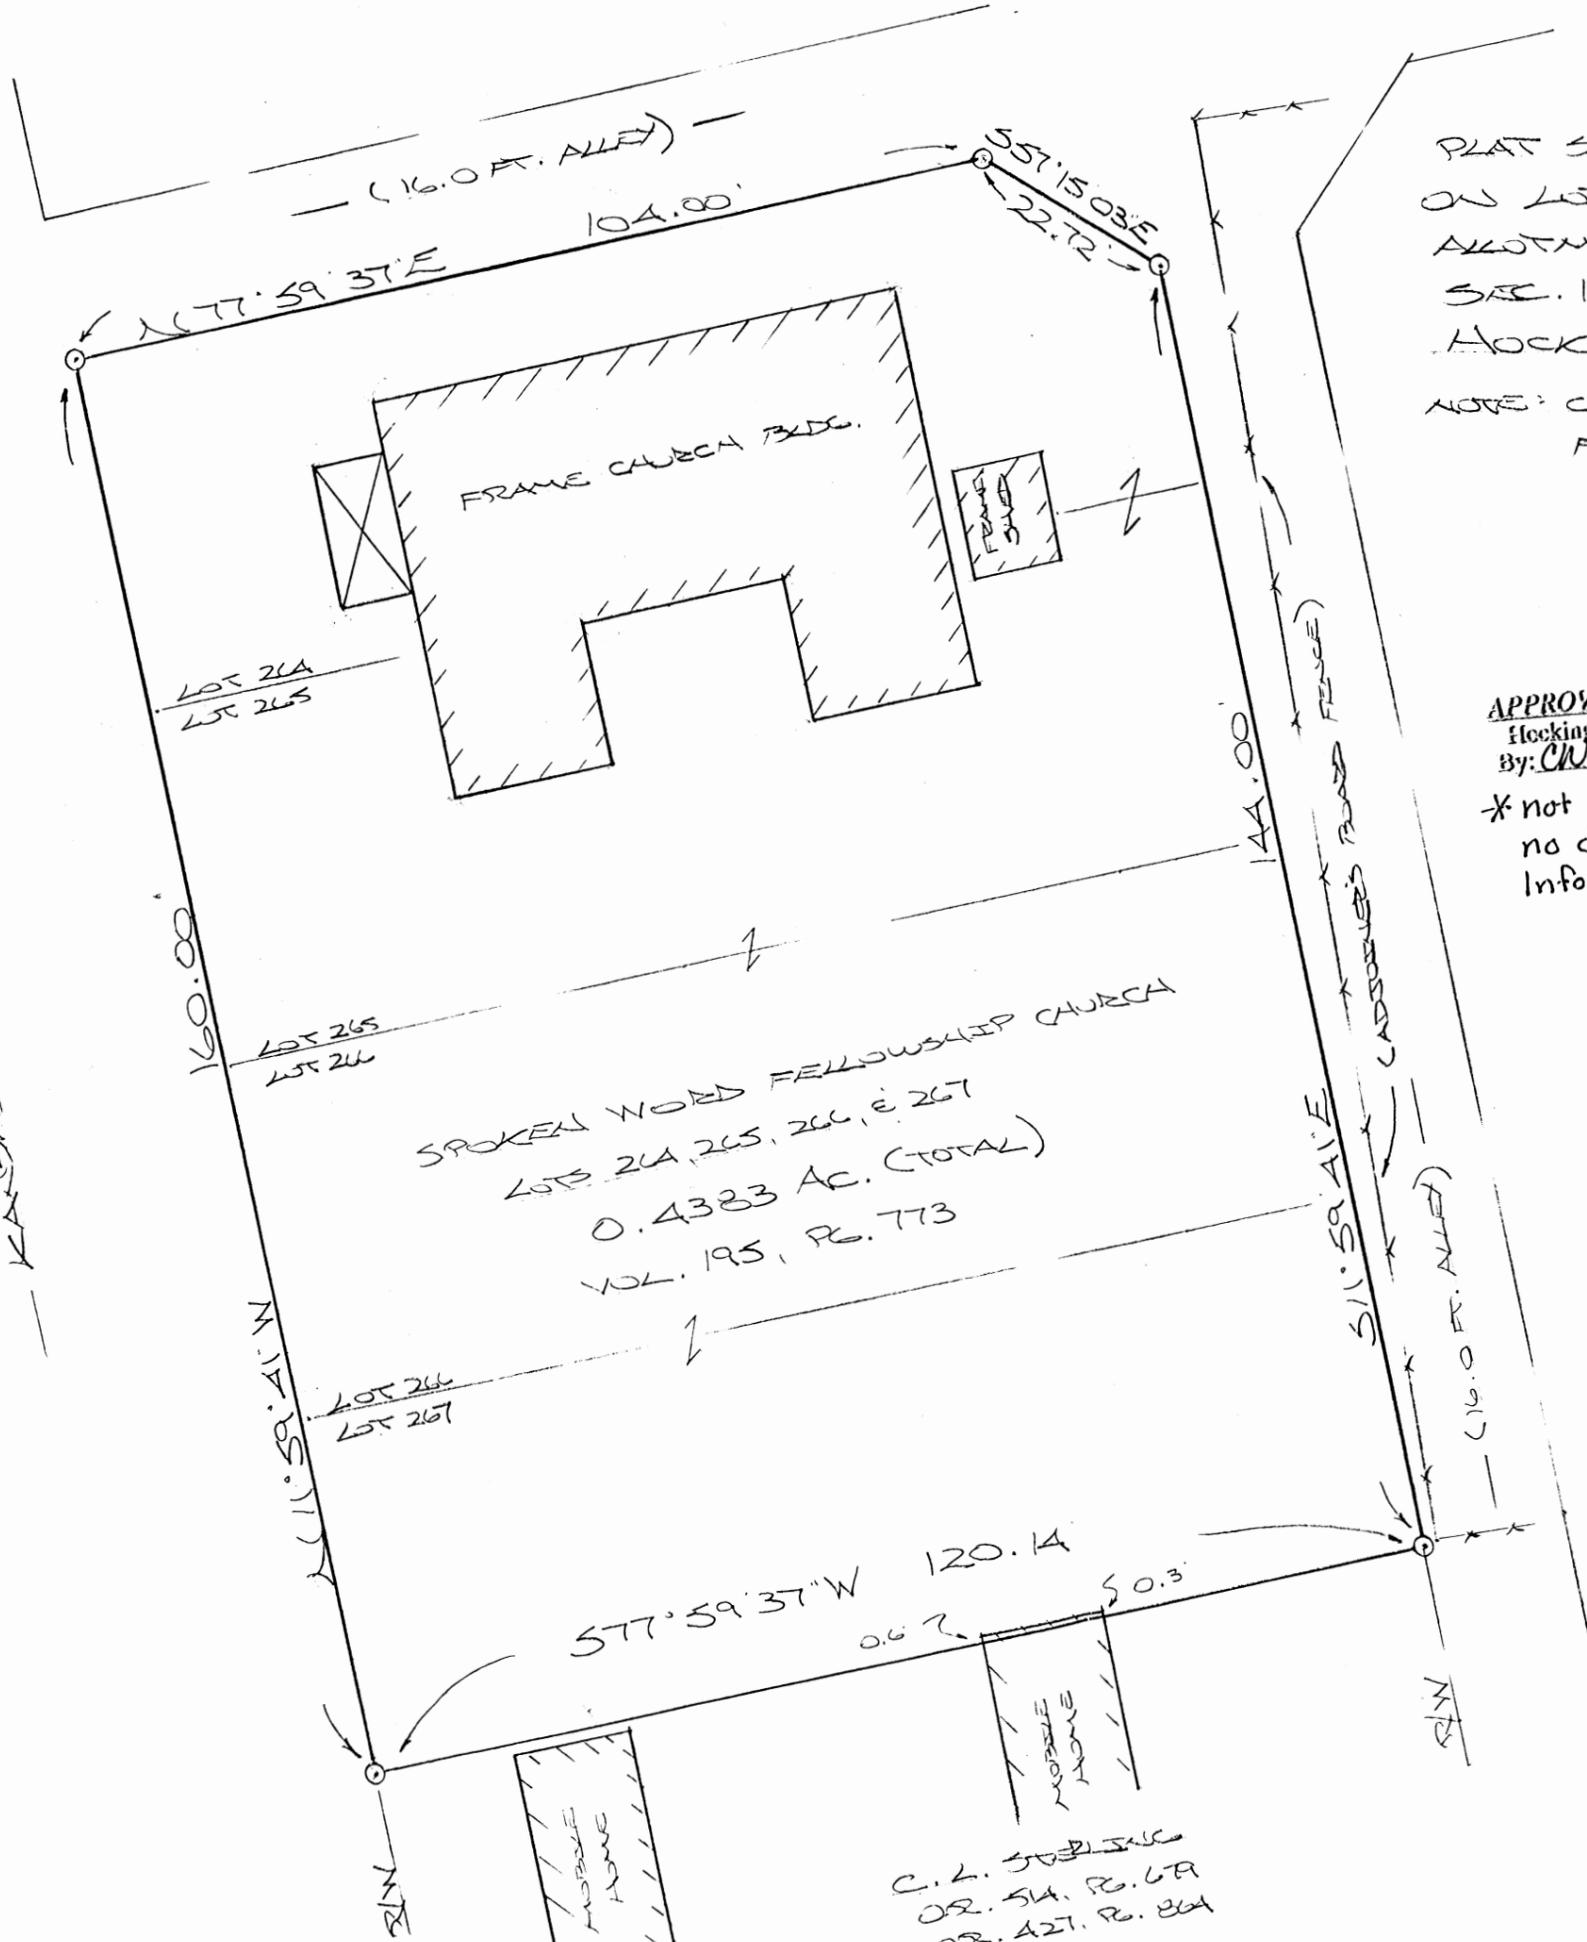


PLAT SHOWING MONUMENTATION AND BLDGS.
ON LOTS 264, 265, 266, & 267 OF "DISKEN'S
ALLOTMENT" OF THE CITY OF LOGAN,
SEC. 12 FALLS TWP., T-14N, R-17W,
HOCKING CO., OHIO

NOTE: CITED BEARINGS ARE BASED ON MONUMENTATION
FOUND ON THE NORTH LINE OF LOT 197
AS RUNNING N 78° 00' 00" E.

APPROVED MATHEMATICALLY
Hocking County Engineer's Office
By: CW Date: M. 4 D. 7. Y. 2014

*not a complete survey,
no description.
Informational purposes only.

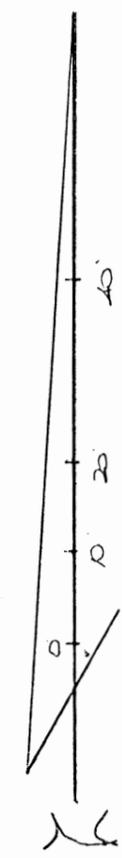

(SCALE: 1" = 20')

- = 5/8" X 30" IRON PEN (SET) W/1/4" PLASTIC ID CAP STAMPED 'MPB-56803'
- = 5/8" IRON PEN (FD.)

PLAT PREPARED FROM SURVEY MADE
MARCH 31, 2014, BY:
ROBERT A. CA-3-14
OHIO REGISTERED SURVEYOR NO. 6803

C. L. JOHNSON
OR. 514, P. 69
OR. 427, P. 864

